


Section 11 Township 32 Range 21 W

Well No. # 1 Stephens "B"

Company Shamrock Oil

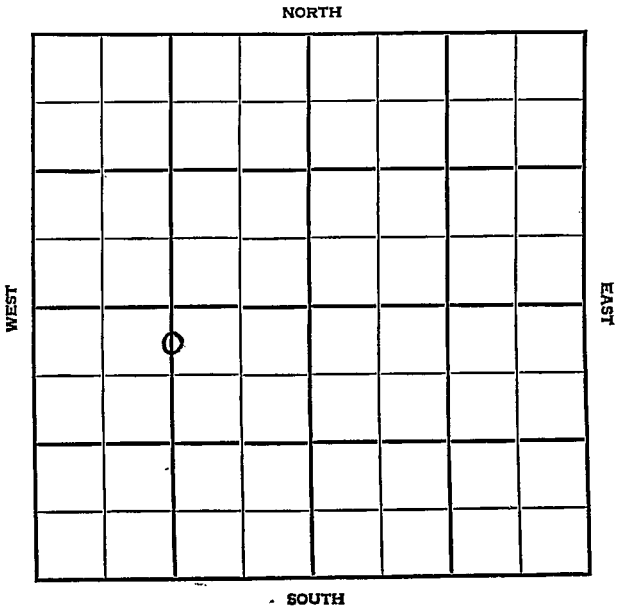

Clark

KANSAS

SEC.	TWP.	R.
11	32	21W

WELL NO.

#1 Stephens "B"

FARM

COMPANY

Shamrock Oil

CONTRACTOR

Co. Tools.

NE Morrison Pool NORTH

_____ Ft. from N. Line	WEST		EAST
2310 _____ Ft. from S. Line			
_____ Ft. from E. Line			
1390 _____ Ft. from W. Line			

C N $\frac{1}{2}$  N $\frac{1}{2}$  SW

	ELEVATION	REPORT
1955	1943'	
2/2	Spud 1-26-55 13" @ 558' WOC	
3/9	Spud 1-26-55 Gas well TD 5160 13" @ 558' Cim. 954 Well. 1509', Hol. 2210', Her. 2379', Kri. 2414', Win. 2446', Ft. Riley 2557', Penn. <del>22</del> 3236', Missouri 4043', KC 4385' Farm. 4770', Cherokee 4992' DST 5122-60 open 1 hr gas in 2 min, spray mud & dist. in 15 min, 12,200,000 CFG 2 $\frac{1}{2}$ gal dist. 1825#. Miss. 5130' TD 5160 7" @ 5160 CO to 5140 36/5127-36 -10,500,000 CF 24 hrs. 12,100,000 CFG 5 hr 50 min. Comp. 31,000,000 CFGPD 4.01 bbl dis	

**COMPLETED**

County **Clark** State **Kansas**

Sec. **11** (Blk.) **32** (Sur.) **21W** Map No.

Operator **Shamrock Oil**

Well No. **1** Farm **Stephens "B"**

Elev. **1943** Location **C N $\frac{1}{2}$  N $\frac{1}{2}$  SW**


**2310** Ft. From **S** Line **SW**

**1390** Ft. From **W** Line **Quarter**

1st. Report **FEB 2 1955**

Completion

Remarks

**Co. tools**

Spudding Date **1-26-55**

Drlg. Data **NE Morrison Pool**

**13" @ 558 WOC**

**FABEN GILSTRAP**

