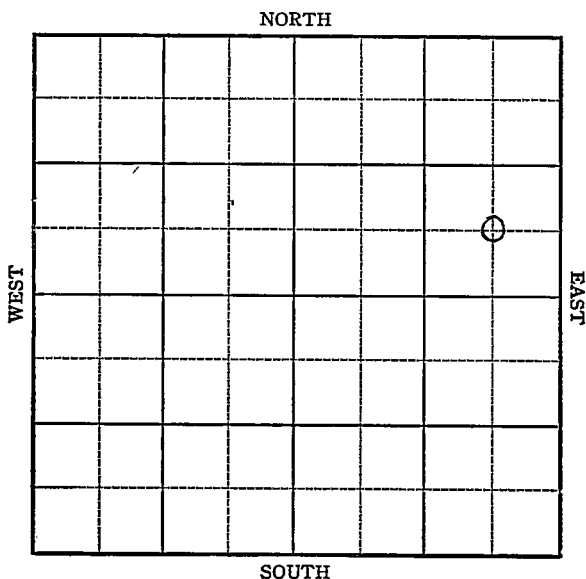



Clark

Section 17 Township 32 Range 21-WWell No. #1 Morrison "c"Company Olson Oil etal.

KANSAS

Sec. 17 Twp. 32 R. 21-WWell No. #1 Morrison "C" FarmOlson Oil etal Company

NORTH

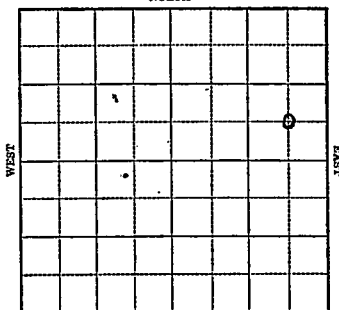 Ft. from N. Line660 Ft. from S. Line660 Ft. from E. Line Ft. from W. Line*Elev. 2101*

1943

R E P O R T

11/3 Cellar

11/10 "

11/17 " Rotary

11/24 "

12/1 12" @ 48

482 Ran 10"

12/8 10" @ 485

Drlg. 870'

12-15 Drlg. 870' SD

12/22 " " "

12/29 " "

1944

1-5 " "

1-12 10" @ 885

8" @ 2147

Drlg 4520'

1/19 Lans 4345

Drlg. 4610

1/26 Drlg. 5051'

2/2 Miss 5330 Drlg.

2/8 Douglas 3870

Drlg. 5763

2/15 6050 Lost circulation cement.

ER

1944

2/23 Kind Shale 5887
Drlg. 6172'

3/1 Drlg. 6434 in Kind

3/8 Viola 6443
Drlg. 6635

3/15 Simp. 6606
Arp. 6755
water
TD 6957

ABANDONED

KANSAS
Map No. 95 Sec. 17 Twp. 32 R. 21WWell No. 1 Morrison "C"Olson Oil et al. Company

FIRST REPORT Contractor

C S E N E

SECTION PLAT

			0

 Ft. from N. Line660 Ft. from S. Line660 Ft. from E. Line Ft. from W. Line

Wildcat

Location Rig up

Drilling and Remarks:

Cellar

RECORD

Cased in., ft.Sand Gas Oil Total Depth

PRODUCTION

1st 24 hrs. Nat. 1st 24 hrs. after shot Gas Cu. Ft.Dry Hole Abandoned

Date

NOV 3 1943 19 S. J. LEWIS Scout

KANSAS

Map No. 95 Sec. 17 Twp. 32 R. 21WWell No. 1 Morrison "C"Olson Oil et al.

Company

ABANDONED

Contractor

C SE NE

SECTION PLAT

 Ft. from N. Line660 Ft. from S. Line660 Ft. from E. Line Ft. from W. Line

Wildcat

Location Rig up

Drilling and Remarks:

*Drill 6606**Per 6755**Water*

RECORD

Cased in., ft.Sand Gas Oil Total Depth 6957

PRODUCTION

1st 24 hrs. Nat. 1st 24 hrs. after shot Gas Cu. Ft.Dry Hole Abandoned

Date

MAR 15 1944 19

S. J. LEWIS

Scout