


Clark

Section 17 Township 32 Range 21-W

Well Number ^{#3} ~~#1~~ Morrison

Company Oleson & Watchorn

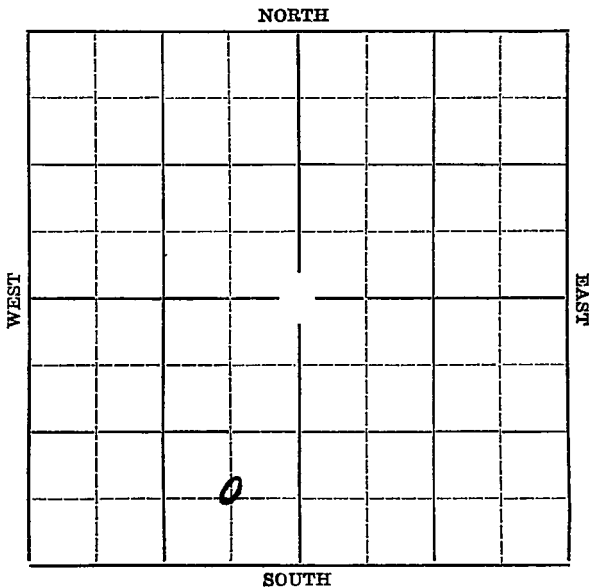

Map No. KANSAS Sec. 17 Twp. 32 R. 21W
Well No. #3 ~~#1~~ Morrison Farm
Oleson & Watchorn Company


 Ft. from N. Line

680' Ft. from S. Line

586' Ft. from E. Line

 Ft. from W. Line

Elev. 2112

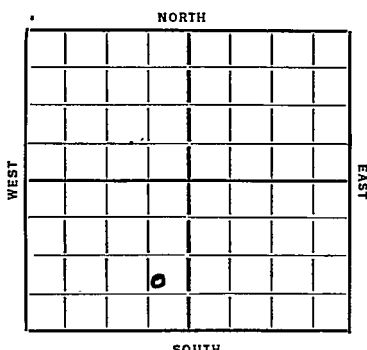

1936

REPORT

6/17	Rig on ground.
6/25	--
7/2	15½" @ 250'. Waiting on cement.
7/9	Drlg. 2615'.
7/16	Drlg. 3591'.
7/23	Drlg. 4068'.
7/30	Drlg. 4790'.
8/6	5110'. Coring.
8/13	8" @ 5143'.
8/20	Clean out.
8/27	Drilling 5200'.
9/3	Lansing 4390'. Drlg. 5353'.
9/10	--
9/18	5459' show gas. Clean out.
9/24	6" @ 3269'. Drlg.
10/1	Drlg. 3780'.
10.8	Drlg. 6140'.
10/15	Drlg. 6240' fishing.
10/22	Drlg. 6478'.
10/29	Viola 6458'. Cored 6481-84'.
	33 bbls of oil. 1¾ bbls in 30 min ^{of water.}
	7" @ 6265' ⁶²⁶⁵ OVER

1936

11/6--Viola 6456 T. D. 6481
Swabbing through 3" tubing
Estimate 1500 to 2000 bbls.
Could not lower oil below
1500' from top.

11/12--Swabbed 205 bbls. in 2 hours
30 feet cavings in hole
Running liner (Tel)

11/12--Pulled tubing getting ready
to swabb through casing.

11/18--Top Viola 6456 T.D. 6481
Treated 3000 gallons acid
Ran 274 feet 5" liner Opened yesterday
Flowed 622 bbls. in 6 hrs.
Potential 2358 bbls. in 24 hrs. flowing
thru 3" tubing This potential based
on 6 hour flow
Very little gas Gravity 41.62
When shut in 5 hrs. would build up
405# pressure (Tel)

11/18--Viola 6456 T. D. 6481
3000 acid. Pot. 2358.
40.8 gravity.

COMPLETED

Clark 95

Map No. **KANSAS** Sec. 17 Twp. 32 R. 21WWell No. 1 MorrisonOleson & Watson Company

Contractor

SECTION PLAT

_____ Ft. from N. Line

680 Ft. from S. Line586 Ft. from E. Line

_____ Ft. from W. Line

FIRST REPORT

Location _____

Rig up _____

Drilling and Remarks:

R.O.G.

RECORD

Cased _____ in., _____ ft.

Sand _____

Gas _____

Oil _____

Total Depth _____

PRODUCTION

1st 24 hrs. Nat. _____

1st 24 hrs. after shot _____

Gas _____ Cu. Ft.

Dry Hole _____

Abandoned _____

Date

JUN 17 1936

19

S. J. LEWIS Scout

Clark
Map No. 95 Sec. 17 Twp. 32 R. 21WWell No. 3 MorrisonOlson & Watchorn Company

Contractor

SECTION PLAT

	0		

_____ Ft. from N. Line

680 Ft. from S. Line586 Ft. from E. Line

_____ Ft. from W. Line

CORRECTION

RECORD

Location _____

Cased _____ in., _____ ft.

Rig up _____

Sand _____

Drilling and Remarks:

Gas _____

Oil _____

Total Depth _____

PRODUCTION.

1st 24 hrs. Nat. _____

1st 24 hrs. after shot _____

Gas _____ Cu. Ft.

Dry Hole _____

Abandoned _____

Date

7/23/36 19 Scout

Clark

Map No. 95 Sec. 17 Twp. 22 R. 21W

Well No. 3 Morrison

Olsen & Watson Company

Contractor

SECTION PLAT

	0		

_____ Ft. from N. Line

680 Ft. from S. Line

586 Ft. from E. Line

_____ Ft. from W. Line

COMPLETED

Location _____

Rig up _____

Drilling and Remarks:

Viola 6456

3000 acid

Box 2358

40.5 gravity

RECORD

Cased _____ in., _____ ft.

Sand _____

Gas _____

Oil _____

Total Depth 6481

PRODUCTION

1st 24 hrs. Nat. _____

1st 24 hrs. after shot _____

Gas _____ Cu. Ft.

Dry Hole _____

Abandoned _____

Date

NOV 18 1936 19

S. J. LEWIS Scout