


Map No. X Sec. 20 Twp. 32 R. 21^N

Well No. 1. Morrison Farm

Waterman & Co Company

NORTH

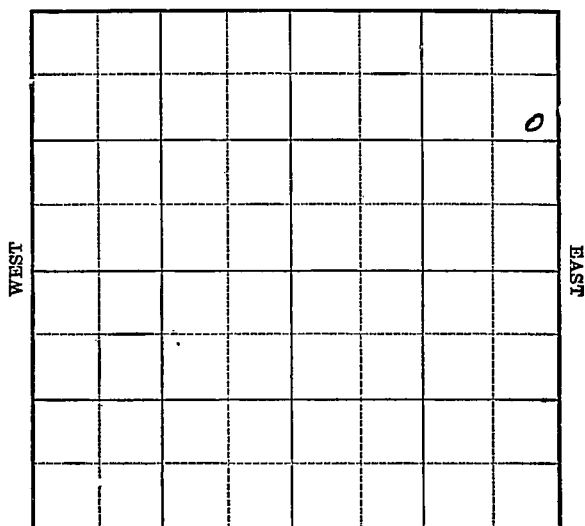

SOUTH

Location _____

Drilling Remarks:

RECORD

Cased _____ in. _____ ft.

Sand _____

Gas _____

Oil _____

Total Depth _____

Rig Up _____

Drilling Remarks:

PRODUCTION

1st 24 hrs. Nat. _____

1st 24 hrs. after shot _____

Gas _____ cu. ft.

Dry Hole _____

Abandoned _____

Map No. 15 Sec. 20 Twp. 32 R. 21 WWell No. 1. Morrison FarmWatchorn Oil & Gas Company
4000' Test on structure


NORTH

1120 Ft. from N. Line

_____ Ft. from S. Line

200 Ft. from E. Line

_____ Ft. from W. Line

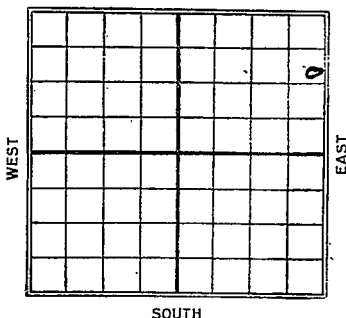

SOUTH

Beneas

Date	REPORT
1924	
4/9	Spd for casing 03140
4/24	Dlg @ 3408'
11/22	Set 6" 3600 set to 4585'
1925	U.R. to 4818'
1/21	Sho oil + Gas @ 4928 moving boiler back
1925	
6/2	Dlg 5290
9/30	" 5580
10/21	T.D. 5690 2 bailers water running 5"
10/28	Bottom Line 5690 T.D. 5700 U.R. 5"
11/4	
11/11	log 5" pipe T.D. 5700'
2/10	
2/10	O. & G. 5679 H.F.W.

Clark Co 20 32 21W
 Map No. No. Map Sec. Twp. R.

Well No. #1 Morrison
 Watchorn O & G. Company

Contractor

4000' Test
 on structure
 120' Ft. from N. Line

Ft. from S. Line

200' Ft. from E. Line

Ft. from W. Line

FIRST REPORT

SECTION PLAT

			0

Location

Rig up

Drilling and Remarks:

S.L.O. for Rig.
 @ 3190'

RECORD

Cased in., ft.

Sand

Gas

Oil

Total Depth

PRODUCTION

1st 24 hrs. Nat.

1st 24 hrs. after shot

Gas Cu. Ft.

Dry Hole

Abandoned

Date

APR 9 1924

M. A. BENEAR

192

Scout

to map
 Map No. **KANSAS**

Sec. *20* Twp. *22* R. *21 W*

Well No. *1 Morris*

Hatchorn O & G. Company

Contractor

SECTION PLAT

1120 Ft. from N. Line

_____ Ft. from S. Line

200 Ft. from E. Line

_____ Ft. from W. Line

ABANDONED

			<i>0</i>

Location _____

Rig up _____

Drilling and Remarks:

T D 66 79 H F W

D & A.

RECORD

Cased _____ in., _____ ft.

Sand _____

Gas _____

Oil _____

Total Depth _____

PRODUCTION

1st 24 hrs. Nat. _____

1st 24 hrs. after shot _____

Gas _____ Cu. Ft.

Dry Hole _____

Abandoned _____

Date

FEB 10 1926

192

S. J. LEWIS

Scout

MAP No. _____ SEC. 20 TWP. 37S R. 21WWELL No. 1 Morrison
Hatchhorn COMPANY

CONTRACTOR

SECTION PLAT

			0

_____ FT. FROM N. LINE

_____ FT. FROM S. LINE

_____ FT. FROM E. LINE

_____ FT. FROM W. LINE

LOCATION _____

RIG UP _____

DRILLING AND REMARKS:

RECORD

CASED _____ IN. _____ FT.

SAND _____

GAS _____

OIL _____

TOTAL DEPTH 5679'

PRODUCTION

1ST 24 HRS. NAT. _____

1ST 24 HRS. AFTER SHOT _____

GAS _____ CU. FT.

DRY HOLE ☒

ABANDONED _____

DATE

2/9 192 6 SCOUT