
Form 51—5M—10-26—Mid-West

Clark

Map No. K5 Sec. 21 Twp. 32 R. 21W

Well No. 1 Stevens Farm

Watchorn Oil Co. Company

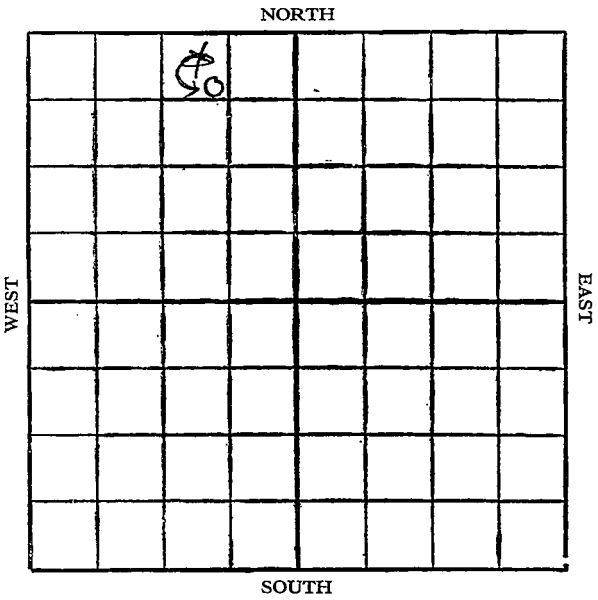

Location	Rig Up
Drilling Remarks	Drilling Remarks
RECORD	PRODUCTION
Cased ..... in. ..... ft.	1st 24 hrs. Nat.
Sand	1st 24 hrs. after shot
Gas	Gas ..... cu. ft.
Oil	Dry Hole
Total Depth	Abandoned

Form 252A—5M—11-25—20913 Clark

Map No. KS Sec. 21 Twp. 32 R. 21 W

Well No. 1 Stevens Farm


Watchorn O & G. Company

630 Ft. from N. Line

~~300~~ Ft. from S. Line

870 Ft. from E. Line

~~990~~ Ft. from W. Line

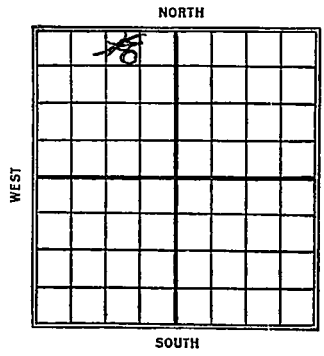

1926

Date	REPORT
11/24	R O G & Tools
12/1	" —
12/8	same
12/15	Drlg. 100'
12/21	12½" @ 194 Drlg 295
12/29	Drlg 1400
~~1927~~	
1/5	Drlg- 2050
1/12	" 2665
1/19	" 2900
1/26	" 3000
2/2	" 3240
2/9	" 3450
2/16	" 3750
2/23	T.D. 3930 fishing drill pipe
3/2	skid rig
3/9	Rigging up
3/16	Spud
3/23	No report
3/30	T.D. 400 lost circulation
	put in 450 sacks cement and
	no circulation —

4/6 - T.D. 400 lost circulation - skid rig -

4/13 - Drlg 345

4/20 - " 890

4/27 - Drlg 4th hole @ 300
T.D. 890 - skid rig 3rd time

5/4 - Drlg 500

5/11 - " 597

5/18 - " 1820

5/25 - " 2400

6/1 - " 2755

6/8 - " 3004

6/15 - " 3190

6/22 - " 3410

6/29 - " 3600

7/6 - " 3890

7/13 - " 4060

7/20 - " 4245

7/27 - T.D. 4290 - fishing 1600' drill pipe which was dropped -

8/3 ———

8/10 - T.D. 4290 - fishing drill pipe -

8/17 - ———

8/24 ———

8/31 ———

9/7 ———

9/14 - T.D. 4290'
D.&A.

FORM 26 250 BKS. 4-28 WESTERN

MAP NO. _____ SEC. 21 TWP. 32S R. 21

WELL NO. 1 C Stevens


Watson

COMP

CONTRACT

No well mapped

SECTION PLAT

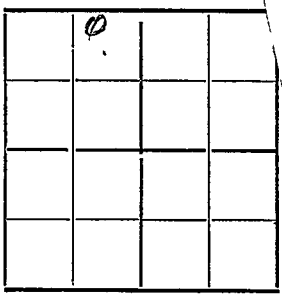

_____ FT. FROM N. LINE

_____ FT. FROM S. LINE

_____ FT. FROM E. LINE

_____ FT. FROM W. LINE

LOCATION _____

RIG UP _____

DRILLING AND REMARKS:

lost hole

RECORD

CASED _____ IN., _____ FT.

SAND _____

GAS _____

OIL _____

TOTAL DEPTH 4240

PRODUCTION

1ST 24 HRS. NAT. _____

1ST 24 HRS. AFTER SHOT _____

GAS _____ CU. FT.

DRY HOLE ✓

ABANDONED _____

DATE 9/14 1927

_____ SCOUT

FORM 26 250 BKS. 4-26 WESTERN

MAP NO. _____ SEC. 21 TWP. 32S R. 21W


WELL NO. 1 Stevens

Matchon COMPANY

_____ CONTRACTOR

No well up

SECTION PLAT

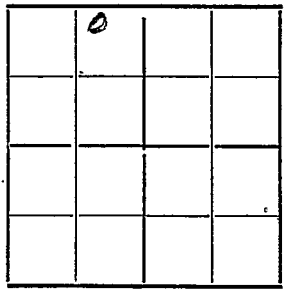

_____ FT. FROM N. LINE

_____ FT. FROM S. LINE

_____ FT. FROM E. LINE

_____ FT. FROM W. LINE

LOCATION _____

RIG UP _____

DRILLING AND REMARKS:

Lost Hole

Plugging 300 Sax

RECORD

CASED _____ IN., _____ FT.

SAND _____

GAS _____

OIL _____

TOTAL DEPTH 3930

PRODUCTION

1ST 24 HRS. NAT. _____

1ST 24 HRS. AFTER SHOT _____

GAS _____ CU.

DRY HOLE _____

ABANDONED ✓

DATE

_____ 192____

Form 26—1M Bks.—3-23—11959.

Clark Kansas


Map No. KANSAS Sec. 21 Twp. 32 R. 21 W

Well No. 1 Stevens

Watchman Oil & G Company

Contractor

SECTION PLAT

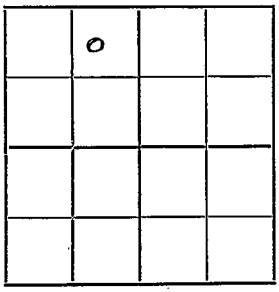

630 Ft. from N. Line

Ft. from S. Line

870 Ft. from E. Line

Ft. from W. Line

ABANDONED

Location

Rig up

Drilling and Remarks:

TD 4290

D&A

RECORD

Cased in., ft.

Sand

Gas

Oil

Total Depth

PRODUCTION

1st 24 hrs. Nat.

1st 24 hrs. after shot

Gas Cu. Ft.

Dry Hole

Abandoned

Date

SEP 14 1927

192

S. J. LEWIS Scout

Form 26—LM Rev. 3-23-11959.


Map No. KANSAS Sec. 21 Twp. 32 R. 21 W

Well No. 1 Stevens

Hutchinson Oil & G. Company

_____ Contractor

SECTION PLAT

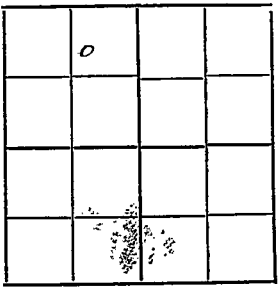

680 Ft. from N. Line.

_____ Ft. from S. Line

870 Ft. from E. Line

_____ Ft. from W. Line

Skid Rig

Location _____

Rig up _____

Drilling and Remarks:

Have skidded this rig three times this is location on fourth hole original hole was 330 N 990.

RECORD

Cased _____ in., _____ ft.

Sand _____

Gas _____

Oil _____

Total Depth _____

PRODUCTION

1st 24 hrs. Nat. _____

1st 24 hrs. after shot _____

Gas _____ Cu. Ft.

Dry Hole _____

Abandoned _____

Date APR 22 1927

182

S. J. LEWIS

_____ Scout

Form 26—1M Bks—3-23—11959.


Map No. KANSAS Sec. 21 Twp. 32 R. 21 W

Well No. 1 Stevens

Waterhorn O & G Company

Contractor

SECTION PLAT

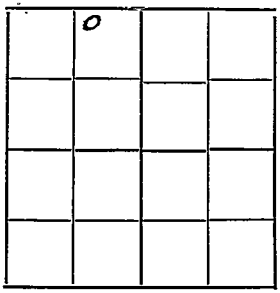

300 Ft. from N. Line

Ft. from S. Line

990 Ft. from E. Line

Ft. from W. Line

FIRST REPORTS

Location

Rig up

Drilling and Remarks:

ROG & tools

RECORD

Cased in., ft.

Sand

Gas

Oil

Total Depth

PRODUCTION

1st 24 hrs. Nat.

1st 24 hrs. after shot

Gas Cu. Ft.

Dry Hole

Abandoned

Date

NOV 24 1926 192

S. J. LEWIS Scout