


Map No. **KANSAS** Sec. **21** Twp. **32** R. **21W**
 Well No. **#1 - Stevens** Farm
Hatchorn Oil Company

NORTH **OLSEN OIL**
ET AL

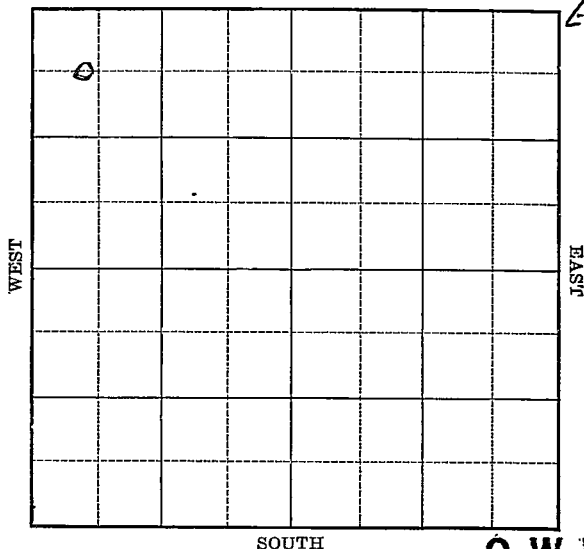

O. W. D. D

Location _____

Drilling Remarks _____

Rig Up _____

Drilling Remarks _____

RECORD

Cased _____ in. _____ ft.
 Sand _____
 Gas _____
 Oil _____
 Total Depth _____

PRODUCTION

1st 24 hrs. Nat. _____
 1st 24 hrs. after shot _____
 Gas _____ cu. ft.
 Dry Hole _____
 Abandoned _____

KANSAS

Map No. Sec. 21 Twp. 32 R. 21W

Well No. #1-3 Stevens Farm

~~Spatchhorn O. & L. Company~~


OLSEN OIL ET AL NORTH

660 Ft. from N. Line

_____ Ft. from S. Line

_____ Ft. from E. Line

500 Ft. from W. Line

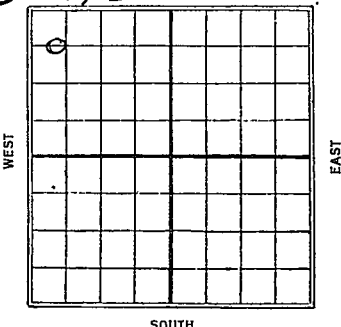

1928

Date	REPORT	O. W. D. D
3/28	Bldg Rig	
4/4	Drill	
4/11	T.D. 400. fishing	
4/18	15 1/2" - 600	
4/25	Rye. 745	
5/2	Drilg 1700	
5/9	" 2700	
5/16	" 3080	
5/23	" 3386	
5/31	" 3820	
6/6	" 4120	
6/13	" 4150	
6/20	" 4460	
6/27	" 4686	
7/3	8" - 4830 - Rust.	
7/11	Rigging up	
7/18	T.D. 4830 - Drilg out Cen.	
7/25	8" @ 4832 - Drilg 4865.	
8/1	Drilg 4902 - H.F.W.	
8/7	" 4921	
8/15	" 4922	
8/22	Drilg 4975	OVER

9/5 - Drly. 5078
 9/12 - " 5085
 9/19 - " 5102'
 9/26 - " 5158'
 10/3 - " 5204'
 10/10 - " 5275'
 10/17 - run 5" @ 5304'
 10/24 - Drly 5336'
 10/31 - 17 At gas 5443'
 Drly 5448'
 11/7 - show oil 5462'
 SD. 5475' T.D.
 11/14 - sand 5443-75
 TD 5475'
 17 At gas
 1 bbl oil show @ 5462
 Sonip

1935 O.W.D.D
 8/21 set whipstock. 4931.
 8/29 fsg 5165
 9/6 Drly 5274
 10/3 " 5900
 10/10 fsg 6204
 11/1 — 11/7 — 11/14 — 11/21 —
 11/29 TD 6234 7" partial fsg
 12/6 —
 12/13 Drly 6319
 12/29 " 6420
 1/2/26 — 1/2/36 — 1/10 —

OVER

1/17 Top Vial 6569
Sho Oil 6575-80
Qty 6711

1/22 Walco 6765
TD 6801
Sho Oil & Water
D & A.

ABANDONED

State No Drilling
 Map No. **KANSAS** Sec. 21 Twp. 22 R. 21W

Well No. 3 StevensWatchorn Oil & G Company

Contractor

SECTION PLAT

660 Ft. from N. Line

Ft. from S. Line

Ft. from E. Line

500 Ft. from W. Line

0			

FIRST REPORTS

Location

Rig up

Drilling and Remarks:

Bldg rig

RECORD

Cased _____ in., _____ ft.

Sand _____

Gas _____

Oil _____

Total Depth _____

PRODUCTION

1st 24 hrs. Nat. _____

1st 24 hrs. after shot _____

Gas _____ Cu. Ft.

Dry Hole _____

Abandoned _____

Date

MAR 28 1928

192

S. J. LEWIS

Scout

Check
No tracing
 MAP NO. KANSAS SEC. 21 TWP. 22 R. 21 W

WELL NO. 3 Stevens
Clatchorn O & G. COMPANY

CONTRACTOR

SECTION PLAT

0			

660 FT. FROM N. LINE

_____ FT. FROM S. LINE

_____ FT. FROM E. LINE

500 FT. FROM W. LINE

COMPLETED

LOCATION _____

RIG UP _____

DRILLING AND REMARKS:

Land 5443 &
5475 - 17 1/4 Gas
1 1/2 oil show
5462.

RECORD

CASED _____ IN. _____ FT.

SAND _____

GAS _____

OIL _____

TOTAL DEPTH 5475

PRODUCTION

1ST 24 HRS. NAT. _____

1ST 24 HRS. AFTER SHOT _____

GAS _____ CU. FT.

DRY HOLE _____

ABANDONED _____

DATE

NOV 14 1928

S. J. LEWIS

192

SCOUT

Map No. 95 Sec. 21 Twp. 32 R. 21W

Well No. 1 - Stevens

Olsen Oil etal Company

Contractor

SECTION PLAT

660 Ft. from N. Line

..... Ft. from S. Line

..... Ft. from E. Line

500 Ft. from W. Line

COMPLETED

0			

OWDD

Location.....

Rig up.....

Drilling and Remarks:

Sho oil & water

D & A

RECORD

Cased..... in., ft.

Sand Wilcox 6765

Gas.....

Oil.....

Total Depth 6801

PRODUCTION

1st 24 hrs. Nat.....

1st 24 hrs. after shot.....

Gas..... Cu. Ft.

Dry Hole.....

Abandoned.....

Date --
JAN 22 1936

192

Scout

CEVA I MANNSCHRECK