

Section 22 Township 32 Range 21WWell No. #1 StephensCompany Panoma Corp.

NORTH

			0				

WEST

EAST

SOUTH

Clark

KANSAS



Sec. 22 Twp. 32 R. 21W

Well No. #1 Stephens Farm

Panoma Corp. Company

Rine Drlg. Contractor

Wildcat

 Ft. from N. Line

990


 Ft. from S. Line

330

 Ft. from E. Line

 Ft. from W. Line

NE SE NW

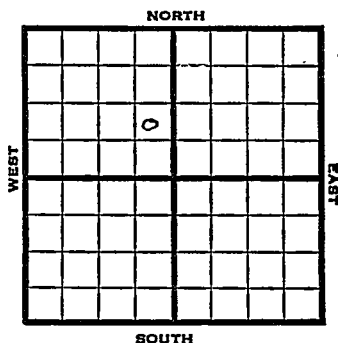

1952

Elev. 2054' REPORT

Miss. Test

10/15

Location

10/22

13" @ 483

Drlg. 2165'

10/29

Making trip @ 3325

11/5

Lans KC 4520

Drlg. 4668'

11/12

Drlg. 5329'

11/19

Spud 10-17-52

D&A

TD 5450'

13" @ 483

Lans 4520, KC 4508, Cherokee

5107, Morrow 5270, Miss 5435

DS^{II} 5304-51, opn 3/4 hrs.,

rec. 42,000 gas, 3330' sw

1830#

TD 5450

DST 5305-20, opn 65 mins.,

rec. 210' sw

1395#

D&A

ABANDONED.

County Clark State Kansas
 Sec. 22 (Blk. 32 (Sur. 21W Map No.
 (Twp.) (Rge.)
 Operator Panoma Corp.
 Well No. 1 Farm Stephans
 Elev. Location NE SE NW


0

FIRST REPORT

990 Ft. From S Line NW
330 Ft. From E Line Quarter
 Ist. Report OCT 15 1952
 Completion
 Remarks Miss. test
Rine Drlg. - Contr.
 Spudding Date

Drlg. Data Wildcat
 Location

County Clark State Kansas
 Sec. 22 (Blk.) 32 (Sur.) 21W Map No. _____
 Operator Panoma Corp.
 Well No. 1 Farm Stephans
 Elev. 2054 Location NE SE NW

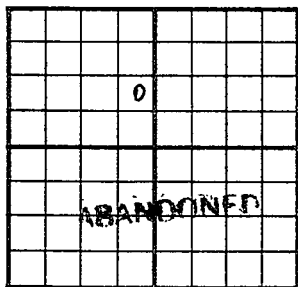

990 Ft. From S Line NW
330 Ft. From E Line Quarter
 Ist. Report _____
 Completion NOV 19 1952
 Remarks Wildcat
Wyant Drlg. - Contr.
 Spudding Date 10-17-52

Drlg. Data D & A TD 5450
13" @ 483 Lans. 4520 KC 4508

Cherokee 5107 Morrow 5270

Miss 5435 DST 5304-51 open 3/4 hr.

Rec. 42,000 gas 3330' sw 1830#

TD 5450 DST 5305-20 open 65 min.

Rec. 210' sw 1395#

D & A

J. G. McGEHEE