

*AMENDED ACO-1

WELL COMPLETION OR RECOMPLETION FORM
ACO-1 WELL HISTORY

```
Operator: license # .....8802.....
name .Cobra Oil & Gas.....
address P.O..Box.1929.....
.....
City/State/Zip ..Woodward..OK..73802-1929.....
```

Operator Contact Person ..Glen A.. Waugh.....
Phone ...(405)..254-2027.....

Contractor: license # ... 5654
name ... Rine Drilling Company

Wellsite Geologist ..Bill Hillman.....
Phone ..(405) 256-3877.....

☒ New Well ☐ Re-Entry ☐ Workover

☐ Oil ☐ SWD ☐ Temp Abd
☐ Gas ☐ Inj ☐ Delayed Comp.
☒ ~~PCV~~ ☐ Other (Core, Water Supply etc.)

11 **OWWO:** old well info as follows:

Operator
Well Name
Comp. Date Old Total Depth

Drilling Method: ☒ Mud Rotary ☐ Air Rotary ☐ Cable

..3-16-86.	..3-23-86.....	3-24-86.....
Spud Date	Date Reached TD	Completion Date

4800'

.....

Total Depth PBTD

Amount of Surface Pipe Set and Cemented at 844' feet

Multiple Stage Cementing Collar Used? ☐ Yes ☐ No

If Yes, Show Depth Set feet

If alternate 2 completion, cement circulated
from feet depth to w/ SX cmt

API NO. 15 - ..025-20,949

CountyClark.

NE... NE... NW... Sec. 36... Twp. 32... Rge. 23... X W
(location)

*3251 4720 Ft North from Southeast Corner of Section 32
 ~~2251~~ Ft West from Southeast Corner of Section 32
 (Note: locate well in section plat below)


Lease Name Red Cliff Farms "36" Well#

Field Name ... Ashland

Producing Formation ... Lansing

Elevation: Ground 2015' KB 2027'

Section Plot

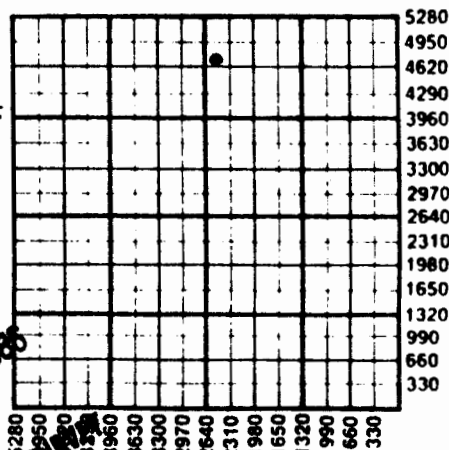

WATER SUPPLY INFORMATION

Source of Water:

Division of Water Resources Permit #

☐ Groundwater. Ft North From Southeast Corner and
(Well) Ft. West From Southeast Corner and

Sec Twp Rge ☐ East West

☐ Surface Water Ft North From Southeast Corner and
(Stream, Pond etc.) Ft West From Southeast Corner

Sec Twp Rge ☐ East ☐ West

☐ Other (explain)
(purchased from city, R.W.D.#)

Disposition of Produced Water: ☐ Disposal ☐ Repressuring

Docket #

INSTRUCTIONS: This form shall be completed in duplicate and filed with the Kansas Corporation Commission, 200 Colorado Derby Building
Wichita, Kansas 67202, within 90 days after completion or recompletion of any well. Rules 82-3-130 and 82-3-107 apply.

Information on side two of this form will be held confidential for a period of 12 months if requested in writing and submitted with the form. See rule 82-3-10 for confidentiality in excess of 12 months.

One copy of all wireline logs and driller's time log shall be attached with this form. Submit CP-4 form with all plugged wells. Submit CP-111 form with: