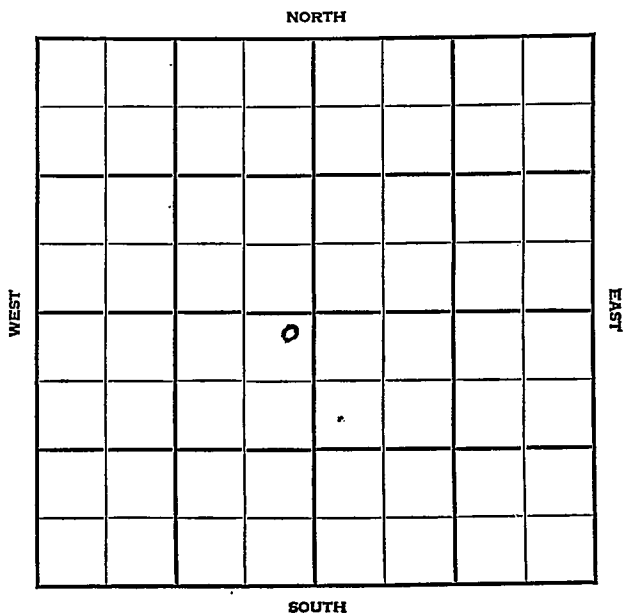


Section 23 Township 32 Range 34WWell No. #1 Baughman "E"Company Cities Service

KANSAS Seward

Sec. 23 Twp. 32 R. 34W

Well No. #1 Baughman "E" Farm

Cities Service Company


Hugoton

100 Ft. from N. Line

 Ft. from S. Line

100 Ft. from E. Line

 Ft. from W. Line

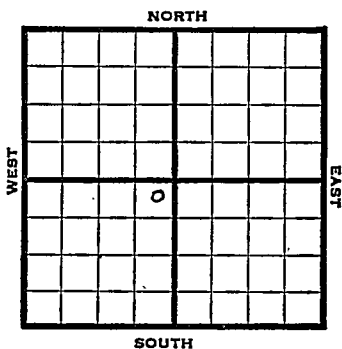

NE SW

1947 Elev. 2901' REPORT

10/1	8" @ 800' WOC
10/8	TD 2750'
10/15	TD 2770' 7" @ 2769'
10/22	150 shots 2688-2718 190 " 2636-74 20 " 2607-11 50 " 2580-90
10/29	"
11/5	29,000 Acid
11/12	"
11/19	"
11/25	"
12/3	"
12/10	"
12/17	"
12/30	"
1948	
1/7	"

OVER

1948

1/14 4 M Gas

1/21 7" @ 2769'
Perf.
31,000 acid
13,600,000 Gas
401# R . Pr.
TD 2770'
Comp.

COMPLETED

Map No. _____ Sec. 23 Twp. 32 R. 34W

Well No. 1 Baughman "E"

Cities Service

Company

FIRST REPORT

Contractor

NE SW


SECTION PLAT

100 Ft. from N. Line

_____ Ft. from S. Line

100 Ft. from E. Line

_____ Ft. from W. Line

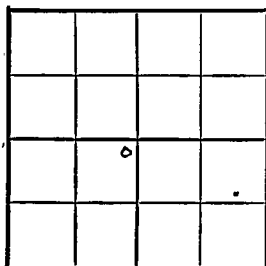

Seward County

Location _____

Rig up _____

Drilling and Remarks:

8" @ 800' WOC

RECORD

Cased _____ in., _____ ft.

Sand _____

Gas _____

Oil _____

Total Depth _____

PRODUCTION

1st 24 hrs. Nat. _____

1st 24 hrs. after shot _____

Gas _____ Cu. Ft.

Dry Hole _____

Abandoned _____

Date

OGT 1 1947

19

S. J. LEWIS

Scout

[Handwritten signature]

Misc. Small Maps	_____
Cards	<i>[Handwritten signature]</i>
Tracing	_____
France Map	_____
Scarborough Map	_____
Pierce Map	_____
Geological Dept.	_____
Pierce Plot Book	_____

Map No. _____ Sec. 23 Twp. 32 R. 34W

Well No. 1 Baughman "E"

Cities Service

Company

COMPLETE

Contractor

NE SW

E1,2901
SECTION PLAT

	6		

100 Ft. from N. Line

_____ Ft. from S. Line

100 Ft. from E. Line

_____ Ft. from W. Line

Seward County

Location _____

Rig up _____

Drilling and Remarks:

7" @ 2768

Prof.

3/1000 acid

13,600,000 Gas

*401 * R/E*

RECORD

Cased _____ in., _____ ft.

Sand _____

Gas _____

Oil _____

Total Depth 2770

PRODUCTION

1st 24 hrs. Nat. _____

1st 24 hrs. after shot _____

Gas _____ Cu. Ft.

Dry Hole _____

Abandoned _____

Date

JAN 21 1948

19

S. J. LEWIS

Scout

Wm G

Misc Small Maps	<i>[initials]</i>
Cards	<i>[initials]</i>
Tracing	<i>[initials]</i>
France Map	<i>[initials]</i>
Scarborough Map	<i>[initials]</i>
Pierce Map	<i>[initials]</i>
Geological Dept.	
Pierce Plat Book	