


Section 36 Township 32 Range 25W

Well No. #1 Duvall

Company Leftwich

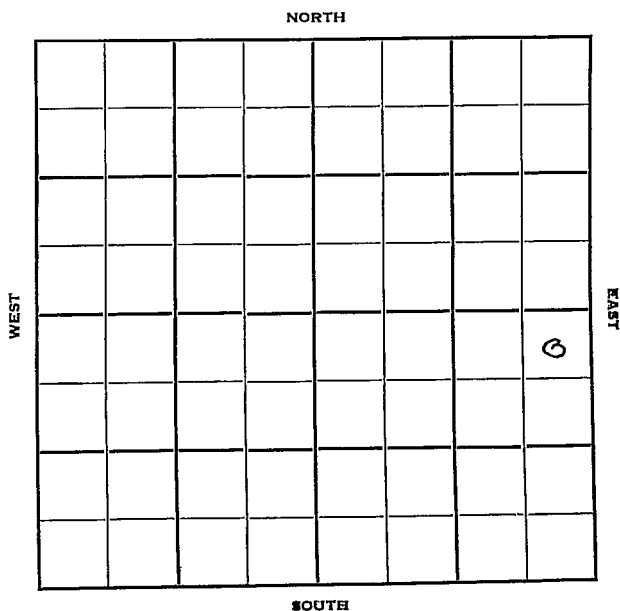

Clark

KANSAS

Sec. 36 Twp. 32 R. 25W

Well No. #1 Duvall Farm

Leftwich Company

Contractor

Wildcat


330 Ft. from N. Line

Ft. from S. Line

330 Ft. from E. Line

Ft. from W. Line

NE NE SE

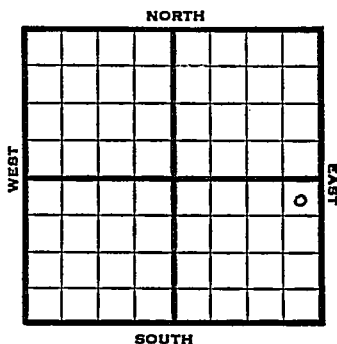

Stanolind FO

1952 Elev. 2195' REPORT

10/15 RUR

10/22 Drlg. 209'

10/29 13" @ 619
Drlg. 2060'

11/5 Drlg. 3655'

11/12 Lans. 4470' ?
Drlg. 4660'

11/20 Marm 4893' Cherokee 5197'
Miss 5377'
Drlg. 5430'

11/26 Spud 10-20-52
D&A

TD 5587'

13" @ 619

Lans 4470', Marm. 4893', Cherokee 5197', Miss 5377, St. Gen. 5523, TD 5587

D&A

ABANDONED

County **Clark** State **Kansas**

Sec. 36 (Bk. 32 (Sur. 257 Map No.

Operator Leftwich

Well No. **1** Farm **Duval**

Elev.	Location	NE	NE	SE
-------	----------	----	----	----

[illegible][illegible]

1st. Report	OCT 15 1952
-------------	-------------

[illegible]


DATE	Remarks
	Stanolind farmout

						/	Spudding Date
--	--	--	--	--	--	---	---------------

Drig. Data Wildcat

R U R

J. G. McGEHFFE

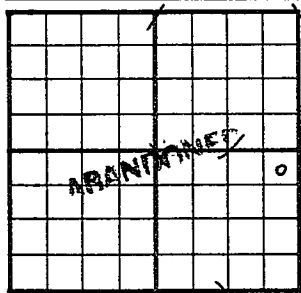County Clark State KansasSec. 36 (Blk.
Twp.) 32 (Sur.
Rge.) 25W Map No.Operator LeftwichWell No. 1 Farm DuvallElev. 2195 Location NE NE SE330 Ft. From N Line SE330 Ft. From E Line Quarter

1st. Report

Completion NOV 26 1952Remarks WildcatSpudding Date 10-20-52Drlg. Data D & A TD 558713" @ 619 Lans. 4470 Marm. 4893Cherokee 5197 Miss. 5377 Sta. Gen. 5523TD 5587D & A