


Meade

KANSAS

SECTION 23 TOWNSHIP 32 RANGE 28W

WELL NO. #1 Singley

COMPANY Thomas-Brewer-Alamo Corp.

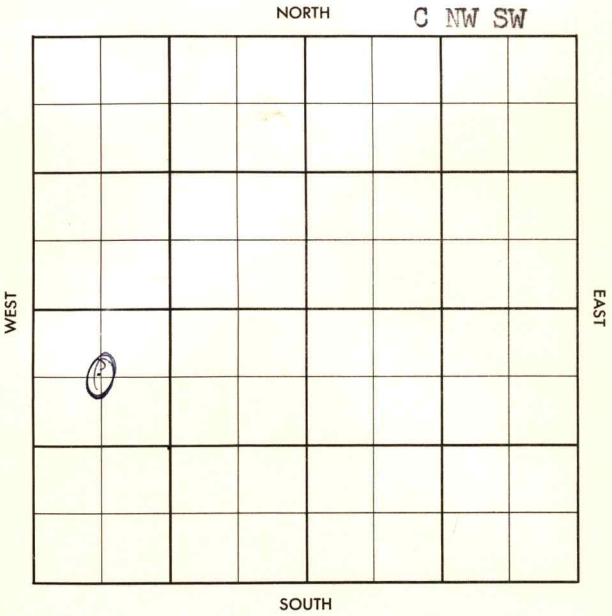

WILDCAT

FORM 513 SUNRAY

County Meade Elev. _____
 Sec. 23 Twp. 32 Rge. 28W
 Company Thomas-Brewer-Alamo Corp.
 Farm Name Singley No. 1

TOPS	DEPTH	LOG	DATUM	Loc. in Sec.
Anh.				CNW SW
TP.				
H.				
Tr.				
Dg.				
BL.				
L.				
K.C.				Geol. _____
B.K.C.				Contr. _____
Ce.				Midwestern
C.				Pool
M.				Wildcat
M.				
K.				
Mz.				
Me.				
V.				
S.				
S.				
A.				
R.				
Pe.				
G.				
T.D.				

Geol. _____
 Contr. _____
 Midwestern
 Pool
 Wildcat

FIRST REPORT
 FEB 27 1957

Date Comm. 2-19-57 Skelly & Shell - DHM
13" @ 1442/500 8" @ 2472/200 WOC

35

2415 DF

County Meade Elev. 2412 DF
 Sec. 23 Twp. 32 Rge. 28W
 Company Thomas-Brewer-Alamo Corp.
 Farm Name Singley No. 1

TOPS	DEPTH	LOG	DATUM	Loc. in Sec.
Anh. <u>Herr</u>	<u>2447</u>			CNW SW
Tp. <u>KRI</u>	<u>2510</u>			
H. <u>WFD</u>	<u>2575</u>			
Tr. <u>ET Rly</u>	<u>2635</u>			
Dg. <u>H3</u>	<u>4245</u>	<u>4245</u>		
Bl. <u>TR</u>	<u>4290</u>	<u>4300</u>		
L. <u></u>	<u>4443</u>	<u>4436</u>		
K.C. <u>Mamm</u>	<u>5027</u>	<u>5020</u>		Geol. <u></u>
B.K.C.				Contr. <u></u>
Ce. <u></u>	<u>5165</u>	<u>5165</u>		Midwestern
C. <u></u>				
M. <u>W</u>	<u>5455</u>	<u>5457</u>		
M. <u>Chester</u>	<u>5469</u>	<u>5471</u>		Pool <u></u>
K. <u></u>				Wildcat
Mz. <u>St Gen</u>	<u>5699</u>	<u>5703</u>		
Ma. <u></u>				ABANDONED
V. <u></u>				
S. <u></u>				
S. <u></u>				
A. <u></u>				
R. <u></u>				
PE. <u></u>				
G. <u></u>				
TD. <u></u>	<u>5755</u>			

Date Comm. 2-19-57 Skelly & Shell - DH

13" @ 442/500 8" @ 2472/200 WOC MAR 6 '57

ID 4778 MAR 13 '57 MAR 20 '57

5402-31 45" 30' mud

7P0 BHP 180/20 t 5443-82

rec. 39' DST 5520-56 20"

10' mud BHP 0/20 p 5556

DEA