

STATE CORPORATION COMMISSION OF KANSAS
OIL & GAS CONSERVATION DIVISION
WELL COMPLETION OR RECOMPLETION FORM
ACO-1 WELL HISTORY
DESCRIPTION OF WELL AND LEASE

Operator: License #07027.....
Name COBRA OIL & GAS CORPORATION.....
Address P.O. Box 1929.....
City/State/Zip Woodward, OK 73802-1929

Purchaser Northern Natural Gas.....
.....

Operator Contact Person Glen A. Waugh.....
Phone 405-254-2027.....

Contractor: License #5654.....
Name Rine Drilling Company.....

Wellsite Geologist Bill Hillman.....
Phone 405-256-1842.....

Designate Type of Completion

☒ New Well ☐ Re-Entry ☐ Workover

☐ Oil ☐ SWD ☐ Temp Abd
☒ Gas ☐ Inj ☐ Delayed Comp.
☐ Dry ☐ Other (Core, Water Supply etc.)

If **OWNO**: old well info as follows:

Operator
Well Name
Comp. Date Old Total Depth.....

WELL HISTORY

Drilling Method:

☒ Mud Rotary ☐ Air Rotary ☐ Cable

.1-13-87..... .1-22-87..... .4-28-87.....
Spud Date Date Reached TD Completion Date

.5700'..... .5665'.....
Total Depth PBTD

Amount of Surface Pipe Set and Cemented at 1501 feet
Multiple Stage Cementing Collar Used? ☐ Yes ☒ No

If yes, show depth set.....feet

If alternate 2 completion, cement circulated
from.....feet depth to.....w/.....SX cmt

Cement Company Name Halliburton.....
Invoice # 498447.....

API NO. 15-.....119
114,20,752
R2:R2L

County Meade.....

..... East
C... NW/4..... Sec. 2... Twp 32S... Rge. 29... X West

.....3960..... Ft North from Southeast Corner of Section
.....3960..... Ft West from Southeast Corner of Section
(Note: Locate well in section plat below)


Lease Name Floyd "2"..... Well #...1.....

Field Name Hockett.....

Producing Formation Chester.....

Elevation: Ground...2662'.....KB.....2674...

Section Plat

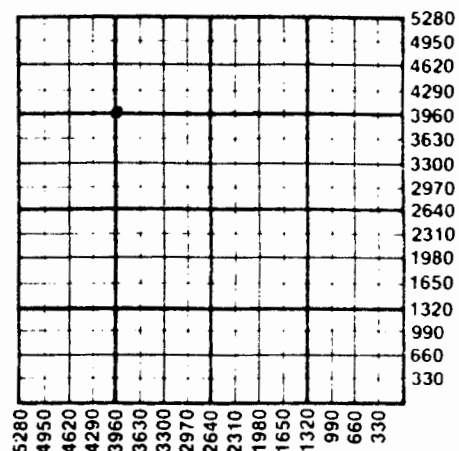

WATER SUPPLY INFORMATION

Disposition of Produced Water: ☐ Disposal
Docket # ☐ Repressuring

Questions on this portion of the ACO-1 call:

Water Resources Board (913) 296-3717

Source of Water:

Division of Water Resources Permit #...T 87-24.....

☒ Groundwater...3960.....Ft North from Southeast Corner
(Well)Ft West from Southeast Corner of
Sec 2 Twp 32S Rge 29 East X West

☐ Surface Water.....Ft North from Southeast Corner
(Stream, pond etc).....Ft West from Southeast Corner
Sec Twp Rge East West

☐ Other (explain).....
(purchased from city, R.W.D. #)

INSTRUCTIONS: This form shall be completed in triplicate and filed with the Kansas Corporation Commission, 200 Colorado Derby Building, Wichita, Kansas 67202, within 120 days of the spud date of any well. Rule 82-3-130, 82-3-107 and 82-3-106 apply.
Information on side two of this form will be held confidential for a period of 12 months if requested in writing and submitted with the form. See rule 82-3-107 for confidentiality in excess of 12 months.
One copy of all wireline logs and drillers time log shall be attached with this form. Submit CP-4 form with all plugged wells. Submit CP-111 form with all temporarily abandoned wells.