

SIDE ONE

STATE CORPORATION COMMISSION OF KANSAS
OIL & GAS CONSERVATION DIVISION
WELL COMPLETION OR RECOMPLETION FORM
ACO-1 WELL HISTORY
DESCRIPTION OF WELL AND LEASE

Operator: License # 8802
Name Cobra Oil & Gas Corporation
Address P.O. Box 1929
City/State/Zip Woodward, Oklahoma 73802

Purchaser Englewood Corporation

Operator Contact Person Glen A. Waugh
Phone (405)-254-2027

Contractor: License # 5654
Name Rine Drilling Company

Wellsite Geologist Ray Goodin
Phone (316)-262-2192

Designate Type of Completion

New Well Re-Entry Workover
 Oil SWD Temp Abd
 Gas Inj Delayed Comp.
 Dry Other (Core, Water Supply etc.)

If **OWWO**: old well info as follows:

Operator
Well Name
Comp. Date Old Total Depth

WELL HISTORY

Drilling Method:

Mud Rotary Air Rotary Cable

10-15-88 10-24-88 11-7-88
Spud Date Date Reached TD Completion Date
5700' 5669'
Total Depth PBTD

Amount of Surface Pipe Set and Cemented at 1500' feet
Multiple Stage Cementing Collar Used? Yes No
If yes, show depth set...feet
If alternate 2 completion, cement circulated from...feet depth to...w/...SX cmt
Cement Company Name
Invoice #

API NO. 15-119-20781
Meade
County
NE NW SE Sec. 2 Twp 32 Rge. 29 East X West

2310 Ft North from Southeast Corner of Section
1600 Ft West from Southeast Corner of Section
(Note: Locate well in section plat below)


Lease Name Lee Well # 1-2

Field Name Hockett Southeast

Chester
Producing Formation

Elevation: Ground 2689' KB 2701'

Section Plat

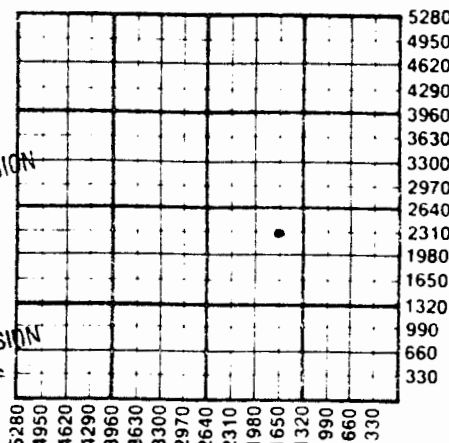

RECEIVED
FEB 2 1989
STATE CORPORATION COMMISSION
CONSERVATION DIVISION
Wichita, Kansas

WATER SUPPLY INFORMATION

Disposition of Produced Water: Disposal
Docket # Repressuring

Questions on this portion of the ACO-1 call:
Water Resources Board (913) 296-3717

Source of Water:
Division of Water Resources Permit # T-88-610

Groundwater 3915 Ft North from Southeast Corner
(Well) 3800 Ft West from Southeast Corner of
Sec 2 Twp 32 Rge 29 East X West

Surface Water...Ft North from Southeast Corner
(Stream, pond etc)...Ft West from Southeast Corner
Sec Twp Rge East West

Other (explain)
(purchased from city, R.W.D. #)

INSTRUCTIONS: This form shall be completed in triplicate and filed with the Kansas Corporation Commission, 200 Colorado Derby Building, Wichita, Kansas 67202, within 120 days of the spud date of any well. Rule 82-3-130, 82-3-107 and 82-3-106 apply. Information on side two of this form will be held confidential for a period of 12 months if requested in writing and submitted with the form. See rule 82-3-107 for confidentiality in excess of 12 months. One copy of all wireline logs and drillers time log shall be attached with this form. Submit CP-4 form with all plugged wells. Submit CP-111 form with all temporarily abandoned wells.

All requirements of the statutes, rules and regulations promulgated to regulate the oil and gas industry have been fully complied with and the statements herein are complete and correct to the best of my knowledge.

Signature Glen A. Waugh
District Manager 2-22-89
Date

Subscribed and sworn to before me this FEB 24 1989 day of Feb 1989
Notary Public Shaw T. Moore
Date Commission Expires 3-21-92

K.C.C. OFFICE USE ONLY
 Letter of Confidentiality Attached
 Wireline Log Received
 Drillers Timelog Received
Distribution
 KCC SWD/Rep NGPA
 KGS Plug Other
(Specify)