


Section 30 Township 32 Range 29W

Well No. #1 Mamie E. Angell

Company Sinclair O & G

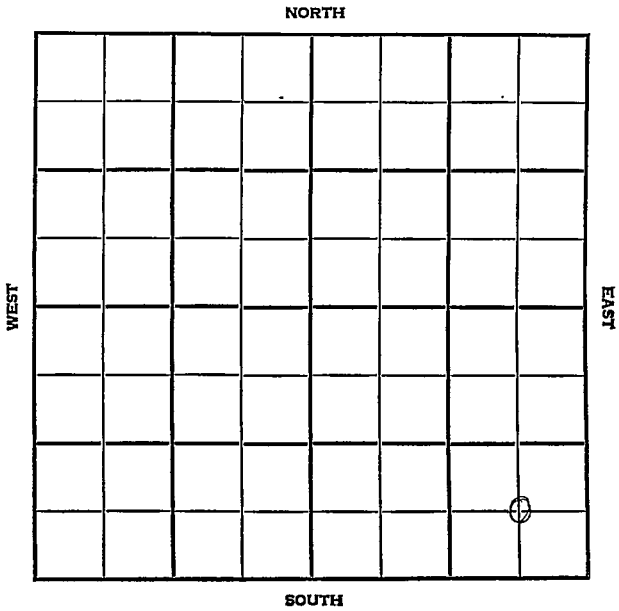

Meade

KANSAS

SEC.

30

TWP.

32

R.

29W

WELL NO.

#1 Mamie E. Angell

FARM

COMPANY

Sinclair O&G

CONTRACTOR

Barbour

WILDCAT


____ FT. FROM N. LINE

____ FT. FROM S. LINE

____ FT. FROM E. LINE

____ FT. FROM W. LINE

C SE SE

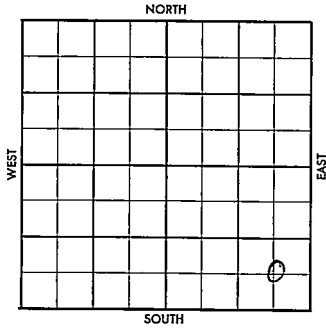

ELEVATION

1956

REPORT

6-6

MIR

6300' test

COMPLETED

5688
2113
M-291

County Meade Elev. 2714
 Sec. 30 Twp. 32 Rge. 29W
 Company Sinclair O & C
 Farm Name Mamie E. Angell No. 1

TOPS	DEPTH	LOG	DATUM	Loc. in Sec.
Anb.				C SE SE
Tr.				6300' test
H.	4373	4374		
Tr.				
Dg.				
Bl.				
L.	4521	4532		
K.C.				Geol.
B.K.C. <u>Marin</u>	5188	5184		Contr.
Gr. <u>MW</u>	5579	5581		<u>Barbour</u>
E. <u>1" sd</u>	5605	5606		<u>Angell disc</u>
M. <u>2" sd</u>	5685	5688		Pool
M.				<u>Well test</u>
K.				
Mz.				
Mo.				
V.				
S.				
S.				
A.				COMPLETE
R.				
Pe.				SEP 2 '56
G.				
T.D.	5780	5783		

Date Comm.

M I R JUN 13 '56 5-6-8
 137 1/8 655/650 1300 JUN 20 '56
 85/8 280.5 11 32.38 JUN 27 '56
 11 4695 JUL 3 '56 11-5558 JUL 11 '56
 or 5608-38 rec 30' DST 5588-5638
 2 hrs rec 30' Md 415/ cored
 5638-70 1/2 Full rec DST 5637-70
 3 hrs 304 MCFG. end of test rec
 60' BCM BHP 1848/30 DST 5662-

30-32-29

CSE-E

5708 3 hrs test 179 MCF acc
 165" GCM 50-50 1850/30"
 DST 5707-28 30" acc 5' Md
 20-20 BHP 20/30" DST
 5730 -80 20" Failed
 5 1/2 @ 5779/250 JUL 18 '56 CO 5744
 36/5655-64 est 100 MCF
 1 1/2 Frac & Ld. JUL 25 '56 60/5688
 -5703 1 1/2 communicated 50g.
 AUG 1 '56 CO 5744 60/5688-5703
 SSG Frac Flw 3 Baph.
 Flw 58 Bo + 24 hrs + 100
 MCFGpd AUG 8 '56 68/5608-12
 52/5639-52 Frac Thg to
 5568 Frac AUG 15 '56 Fld 500
 MCFG AUG 22 '56 ✓ Flw 9 Ld +
 1 Mill CFG 1" ch. AUG 29 '56
 Flw 9 Ld + 1 Mill CFG
 SEP 5 '56 Flw Ld + 10 B new
 oil 24 hrs Flwd 19 Bo 1" choke
 grav. 35° + 800 MCFG. SEP 1 - '56
 PB corr to 5671 PF Pl.
 41 Bopd + 800 MCFG 1" ch
 TP 38 CP 120# 9 new 35°

30-32-29

CSE-E

County Meade Elev. _____
Sec. 30 Twp. 32 Rge. 29W
Company Sinclair O & G
Farm Name Mamie E. Angell No. 1

TOPS	DEPTH	LOG	DATUM
Anh.			
TP.			
H.			
Tr.			
Dg.			
BL.			
L.			
K.C.			
B.K.C.			
Ce.			
C.			
M.			
M.			
K.			
Mz.			
Me.			
V.			
S.			
S.			
A.			
R.			
Pe.			
G.			
TD.			

Loc. in Sec. C SE SE
6300' test
Geol. _____
Contr. _____
Barbour
Pool _____
Wildcat

FIRST REPORT			
JUN 6 '56			
			0

Date Comm. M I R

[Handwritten signature]

Co.
Lse.
No.
Sec.
T.
R.