

Meade

KANSAS

SECTION 11 TOWNSHIP 32 RANGE 29W


WELL NO. #1 A.D. Sanders "G"

COMPANY Texas Company

NORTH

WEST

EAST

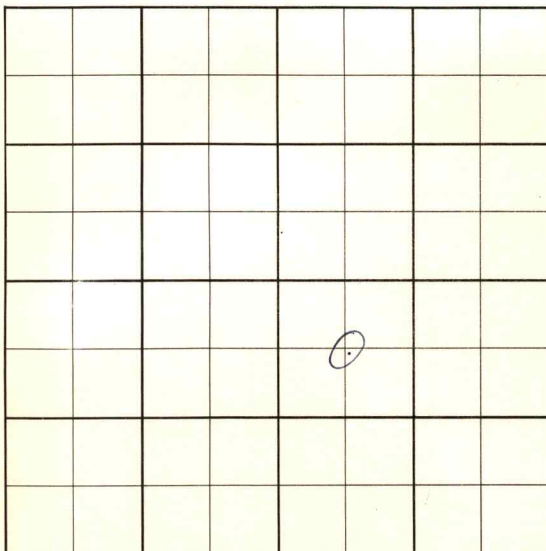

SOUTH

County Meade Elev. 2670
 Sec. 11 Twp. 32 Rge. 29W
 Company Texas Company
 Farm Name A. D. Sanders "C" No. 1

TOPS	DEPTH	LOG	DATUM	Loc. in Sec.
Anh.				C NW SE
Tp.				
H.		4384		
Tr. <u>LS</u>		4523	-1856	
Dg. <u>MAR 17</u>	5126	5124		
Bl.				
L.				
K.C.				Geol.
B.K.C.				Contr.
Ce.	5284	5286	-1416	Noble
C.				
M. <u>MW</u>	5532	5502	-2876	
M. <u>" 3d</u>		5553	-2877	Pool
K. <u>17135</u>		5600	-2924	Sanders
Mz.				
Mo.				
V.				
S.				
S.				
A.				
R.				
PE.				
G.				
T.D.	5705			

COMPLETE
 FEB 27 '57

Date Comm. 1-13-57

8" @ 1179/750 JAN 23 '57 Fshg @ 3525

JAN 30 '57 @ 4000 FEB 6 '57 @ 5370 FEB 13 '57

ord 5535-60 rec 16' ord 5560

-95 Full rec. ord 5597-5656

rec 59' 5 1/2 5704/200 WOC

FEB 20 '57 30/5640-52 tst dry in

tst 300 MCFG + 30 Gwph 64/

5614-30 in tst 300 MCFG +

40 G Acid Wht FV2C tst 1.250

FORM 513-1 SUNRAY

MCFGPD S.I. FEB 27 '59 72-20

ga 6.940 MCFG SIP 1560#

County Meade Elev. _____
 Sec. 11 Twp. 32 Rge. 29W
 Company Texas Company
 Farm Name A. D. Sanders "C" No. 1

TOPS	DEPTH	LOG	DATUM	Loc. in Sec.
Anh.				C NW SE
Tp.				
H.				
Tr.				
Dg.				
BL.				
L.				Geol.
K.C.				Contr.
B.K.C.				Noble
Ce.				
C.				Pool
M.				Sanders
M.				
K.				
Mz.				
Me.				
V.				
S.				
S.				
A.				
R.				
Pe.				
G.				
T.D.				

FIRST REPORT	
JAN 16 57	

Date Comm. 1-13-57

8" @ 1479/750

35

O.W.W.O.

23

S-513-B

County Meade Elev. 2676
 Sec. 11 Twp. 32 Rge. 29W
 Company Texas Company
 Farm Name A. D. Sanders "C" No. 1

TOPS	DEPTH	LOG	DATUM
Anh.			
Tp.			
H.			
Tr.			
Dg.			
B.L.			
L.			
K.C.			
B.K.C.			
Ce.			
C.			
M. <u>W sh.</u>	<u>5502</u>		
M. <u>W sd.</u>	<u>5553</u>		
K. <u>Miss</u>	<u>5600</u>		
Mz.			
Mq.			
V.			
S.			
S.			
A.			
R.			
Pf.			
G.			
T.D.	<u>5705</u>		

Loc. in Sec.

C NW SE

OWWO

Geol.

O.W.W.O.

Contr.

Pool

Sanders

COMPLETE
 TEST REPORT
 MAR 12 1958

Date Comm.

OT D 5705

5" @ 5704 PB 5690 36/ 5640-52

64/ 5614-30 2000 A frac

Comp. as gas well 2-27-57

SP 5590 52/ 5553-66 frac

Comp. 1,620 mcf/gpd