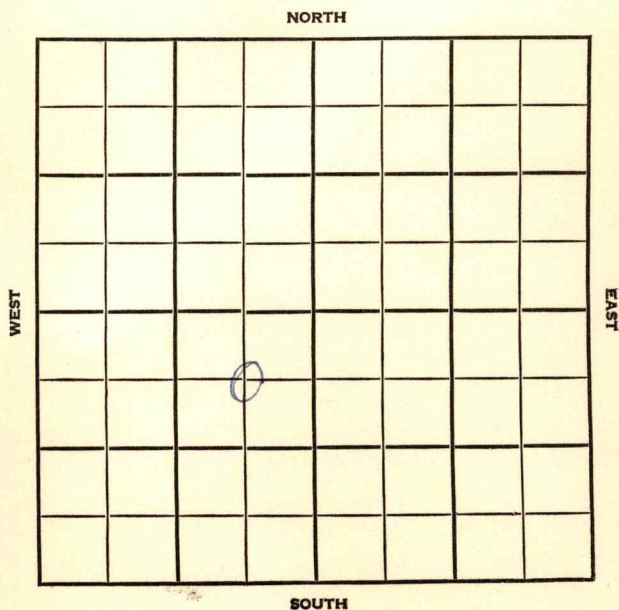


Section 12 Township 32 Range 29WWell No. #1 A.D. Sanders "B"Company The Texas Co.

County Meade Elev. _____
 Sec. 12 Twp. 32 Rge. 29W
 Company The Texas Co.
 Farm Name A.D. Sanders "B" No. 1

TOPS	DEPTH	LOG	DATUM	Loc. in Sec.
Anh.				C NE SW
Tr.				
Dg.				
Bl.				
L.				Geol.
K.C.				Contr.
B.K.C.				Noble Drlg.
Ce.				Pool
C.				Sanders
M.				
M.				
K.				
Mz.				
Me.				
V.				
S.				
S.				
A.				
R.				
Pe.				
G.				
T.D.				

DEC 5 1956
 FIRST REPORT

Date Comm. 11-29-56
10" @ 1499 w/900, Drlg. 2625

35

County Meade Elev. 2665
 Sec. 12 Twp. 32 Rge. 29W
 Company The Texas Co.
 Farm Name A.D. Sanders "B" No. 1

TOPS	DEPTH	LOG	DATUM	Loc. in Sec.
Anh.				C NE SW
Tp.				
H.	4384	4384		
Tn.	4422	4424		
Dg.				
Bl.				
L.	4544	4542		
K.C. <u>Marm</u>	5158	5156		Geol.
B.K.C.				
Ce.	5225	5221		Contr.
C. <u>MISS</u>	5564	5563		Noble-Drlg.
M.				
M. <u>MW</u>		5516		
K. <u>" 3d</u>		5548		Pool
Mz.				
Mo.				Sanders
V.				
S.				
S.				
A.				
R.				
Pe.				
G.				
TD.	5676			

COMPLETE

JAN 9 '57

Date Comm. 11-29-56

10" @ 1499 w/900, Drlg. 2625 DEC 12 '56

ID 4160 DEC 19 '56 ID 5449 DEC 26 '56

Ord 5520-80 rec 60' 7" @ 5675

1250 MICT JAN 2 '57 CO 5644 Load w/

oil 56/5580-94 N.S. 32/5556-74

N.S. N \$ Ld Flwd 4,737

MLFG 27/64" ch TP 715 H FRAC

ga 5,909 MCF + spray wtk S.I.

For 72-20 JAN 9 '57 72-20 ga 12,295

MLFGDD SIP 1580#