


Section 8 Township 32 Range 30W
Well No. #1 Langhofer
Company Wakefield & CRA

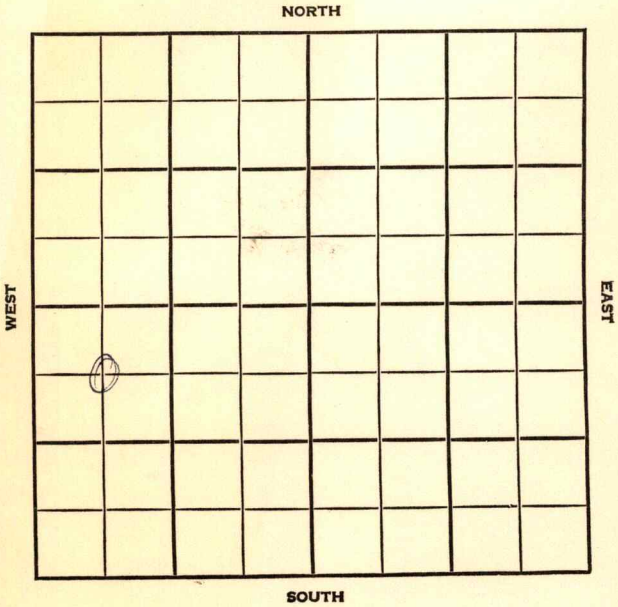

County Meade Elev. 2780 KB
 Sec. 8 Twp. 32 Rge. 30W
 Company Wakefield & CRA
 Farm Name Langhofer No. 1

TOPS	DEPTH	LOG	DATUM	Loc. in Sec.
Anh.				C NW SW
Tr.				
H.	4339	4323		
Tr.				
Dg.				
Bl.				
L.	4460	4457		Geol.
K.C.				
B.K.C.	5014	5008		Contr.
Ce. <u>Marion</u>	5079	5073		Wakefield Tools
C.e.	5240	5235		
M. <u>ATOK</u>		5376		Pool
M. <u>MUSD</u>	5555	5552-56		
K. <u>MISS</u>	5612	5611		
Mz. <u>MUSK</u>		5549		
Ma.				
V.				
S.				
S.				
A.				
R.				
Pe.				
G.				
T.D.	5716			

ABANDONED
 JAN 30 '57

Date Comm. spd. 10-13-56

8" @ 1600 w/700, WOC OCT 24 '56 // 3068

OCT 31 '56 // 4509 NOV 7 '56 // 5442

DST 5547-68 1hr see 90'

USO SPKD Md +180' 900'

FP 20-20 BHP 100/30 DST

5541-5600 1hr see 90' GCM

FP 250-750 BHP 100/30"

DST 5592-5650 1hr 90' Md

FP 10-10 BHP 10/30" S.D.

NOV 21 '56

5 1/2 @ 5705/150 CO 28/5555
 -72 FRAG NOV 28 '56 20 x 20 F/g Ld
 DEC 5 '56 DEC 12 '56 Rec Ld 8 20

Bo no/w 24 hrs DEC 19 '56 W.O.O.
 DEC 26 '56

JAN 2 '57 JAN 9 '57 JAN 16 '57
 JAN 23 '57 JAN 30 '57 no new oil

(was All Load)

h/c a

 Sec. 8 Twp. 32 Rge. 30W
 Company Wakefield & CRA
 Farm Name Langhofer No. 1

TOPS	DEPTH	LOG	DATUM	Loc. in Sec.
Anh.				C NW SW
TP.				
H.				
Tr.				
Dg.				
BL.				
L.				Geol. _____
K.C.				Contr. _____
B.K.C.				Wakefield Tool
Ce.				Pool
C.				
M.				
M.				
K.				
Mz.				
Mq.				
V.				
S.				
S.				
A.				
R.				
PE.				
G.				
T.D.				

FIRST REPORT

0

OCT 17 1956

Date Comm. spd. 10-13-56
8" @ 1600 w/700, WOC

35