

DX 78-1


Meade

KANSAS
30W

Section 20 Township 32 Range 30W

Well No. #1 Bender

Company Shamrock Oil & Gas

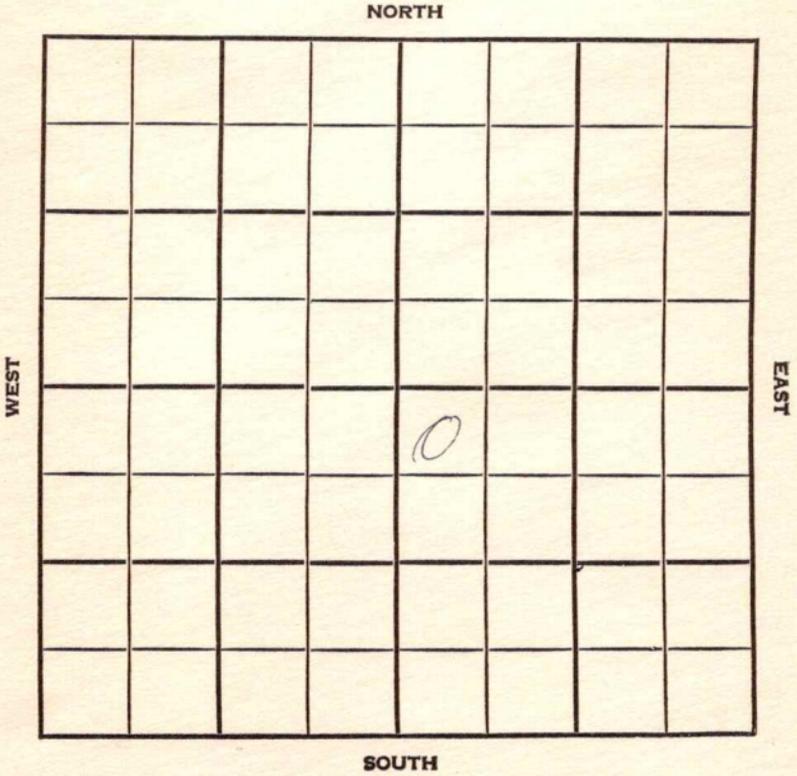

County Meade Elev. 2775 DF

Sec. 20 Twp. 32 Rge. 30W

Company Shamrock Oil & Gas

Farm Name Bender No. 1

TOPS	DEPTH	LOG	DATUM
Anh.			
TP.			
H.			
Tr.			
Dg.			
Bl.			
L.			
K.C.			
B.K.C.			
Ce.			
C.			
M.			
M.			
K.			
Mz.			
Ma.			
V.			
S.			
S.			
A			
R.			
PE.			
G.			
TD.			

Loc. in Sec. NW NW SE

Geol. _____

Contr. _____

Pool

Stevens

FIRST REPORT

OCT 24 56

1/2 mile code

Date Comm. United Prod. (FO)

WORT 6000' est. TD

NOV 5 1956

R.G.

[Handwritten signature]

Co.

Lse.

No.


Sec.

T.

R.

County Meade Elev. 2775 DF
 Sec. 20 Twp. 32 Rge. 30W
Sharrock Oil & Gas
Bender No. 1

	TOPS	DEPTH	LOG	DATUM	Loc. in Sec.
Anh.	<u>Herr</u>	<u>2725</u>			NW NW SE
Tp.					
H.					
Tr.					
Dg.					
Bl.	<u>show</u>		<u>4350</u>		
L.	<u>H6</u>		<u>4380</u>		Geol.
K.C.	<u>TR</u>		<u>4416</u>		
B.K.C.	<u>LS9</u>		<u>4520</u>		Contr.
Ce.	<u>M81M</u>		<u>5080</u>		
C.	<u>CC</u>		<u>5240</u>		
M.	<u>Atokd</u>		<u>5264</u>		
M.	<u>Mw 5h</u>		<u>5562</u>		Pool
K.	<u>MISS</u>		<u>5618</u>		<u>Stevens</u>
Mz.					
Ma.					
V.					
S.					
S.					
A.					
R.					
Pe.					
G.					
TD.		<u>5730</u>			

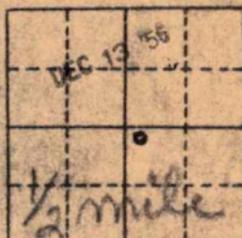Date Comm. United Prod. (FO)WORT 6000' est. TD OCT 31 '5610-26-56 1510 NOV 7 '562458 NOV 13 '56 9 @ 1320stuck @ 1500' Trying to run9" PTD 2730 NOV 21 '56 9" @2735/900 2944 NOV 28 '56 4500DEC 5 '56 5523 DEC 12 '56 CRD 5582-5617 rec. 35' (V550) crd 5617-67 rec. 46' N.S. D & A