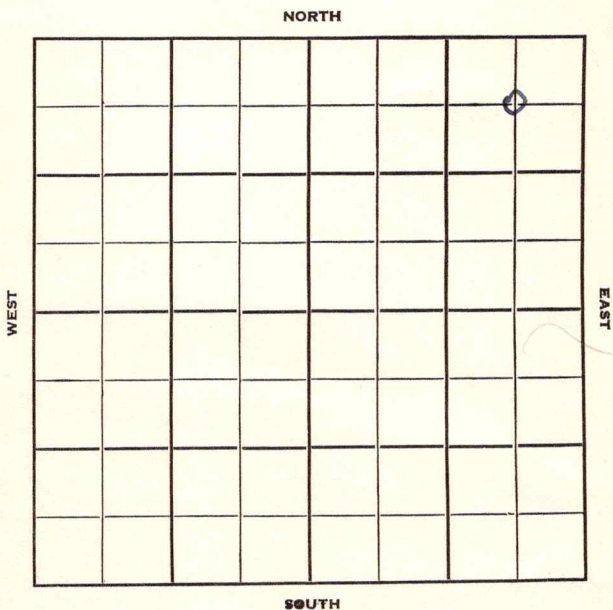


Section 32 Township 32 Range 30 WWell No. # 1 C. E. StevensCompany Columbian Fuel

Meade

HOT FILE ✓
KANSAS

Sec. 32 Twp. 32 R. 30W

Well No. #1 C. E. Stevens Farm

Columbian Fuel Company

Contractor

Wildcat


660' Ft. from N. Line

Ft. from S. Line

660' Ft. from E. Line

Ft. from W. Line

C NE NE

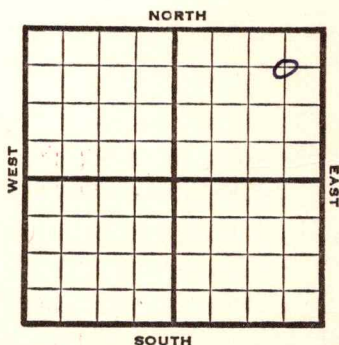

1952	Elev. 2757	REPORT
6/25	13" @505 WOC	
7/2	Hol 2598'	RTD 2681' 9" @?
7/9	9" @ 2672 Her 2651 DST 2782-3820 1 hr. 240' wtr Drlg. 3690	
7/17	Krider 2700' Winfield 2751' Up Ft. 2837' Low Ft. 2914' Florance Flint 2990' Lans. 4305' DST 4299-4370 1 hr, 990' SW 1215# DST 4550-91, 1 hr, 1530' SW 1330# Drlg. 4610'	
7/23	DST 4910-58, 1 hr. 1173' SW 1600# F 5054-5105, 50½ shale & lime DST 5072-5105, 2 hrs. 125' V HO&GCM 270' SW 1215# DST 5069-84 w/double pkr. 1½ hr. 40' HOCM 135#	
7/30	f 5105-56, 51' li & shale f 5156-92 36' li DST 5147-92, 1 hr. 55' m FP 30 1335# f 5193-5242 49' shale & li DST 5242-93 51' li shale Fishing @ 5297'	
8/6	DST 5398-5418 1 hr. 15' M Coring 5480-5531 51' li stain & sh Coring 5532-74 27' li & sh 15' sd Drlg.	

OVER

1952

8/13 DST 5626-90, 1 hr. 70' GCM
Drlg. 5773'

8/20 RTD 6000 Schl 5" @ 5671

8/27 PB 5640' to perf.

9/3 42/5619-26 $3\frac{1}{2}$ M Sq off
42/5619-26 500 A

9/10 PB 5615 12/5603-05 sq off
60/5572-82 $1\frac{1}{2}$ M gas & SW
500 A gas increasing

9/17 41/ 5572-82 1,913,000 gas
48/ 5560-72 60/ 5582-97
S-Frac. 5560-97

9/24 Spud 6-23-52 Gas Well TD 5995
13" @ 505 Hol. 2598 TD 2681
9" @ 2672 Her. 2651

DST 2782-2820 opn 1 hr. Rec. 240'
wtr Kri 2700 Win. 2751

Ft. Riley 2837 Florence Flint 2990
Lans. 4305

DST 4299-4370 opn 1 hr. Rec. 990' sw

DST 4550-91 opn 1 hr. Rec. 1530' sw

1330# DST 4910-58 opn 1 hr.

Rec. 1173' sw 1600# DST 5072-5105

opn 2 hr. Rec. 125' vhoem 270' sw

1215# DST 5069-84 opn $1\frac{1}{2}$ hr.

Rec. 40' hoem 135# DST 5147-92

opn 1 hr. Rec. 55' mud 1335#

DST 5187-5242 opn 1 hr.

Rec. 11' mud 0# DST 5398-5418

opn 1 hr. Rec. 15' mud

→ DST 5626-90 opn 1 hr. Rec. 70' gcm

DST 5808-16 opn 1 hr Rec. 20' sgcm

TD 6000 5" @ 5671 DST 5556-74 opn

$\frac{1}{2}$ hr. Rec. 55' gcm 2 mcfg 1845#

DST 5555-91 opn 1-3/4 hr. Rec. 155'

gcm 4,370,000 G 1750#

DST 5590-5626 opn $1\frac{1}{4}$ hr. Rec. 70'

gcm scum oil 582,000 gas 1670#

DST 5808-16 opn 1 hr. Rec. 20' sgcm

0# TD 5995 5" @ 5671 PB 5640

42/5619-26 $3\frac{1}{2}$ mcfg 42/5619-26

500 A PB 5615 12/5603-05

60/5572-82 $1\frac{1}{2}$ mcfg & sw 500 A 5590

41/5572-82 1,913,000 gas 2757

48/5560-72 60/5582-97 sd-frac-2833

5560-97 Marm 5075 Marm Sd 5559 2869

Chester 5620 St. Gen 5838


Comp. 8,755,000 gas

COMPLETED

5559

2757

2833

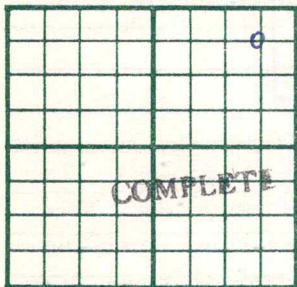County Meade State KansasSec. 32 (Blk. 32 (Sur. 30W Map No. 32 (Twp. 30W (Rge. 30W)Operator Columbian FuelWell No. 1 Farm C. E. StevensElev. 2757 Location C NE NE660 Ft. From N Line NE660 Ft. From E Line Quarter


1st. Report


Completion SEP 24 1952Remarks WildcatSpudding Date 6-23-52Drilg. Data Gas well TD 599513" @ 505 Hol. 2598 TD 26819" @ 2672 Her. 2651 DST 2782-2820open 1 hr. Rec. 240' wtr. Kri. 2700Win. 2751 Ft. Riley 2837 FlorenceFlint 2990 Lans. 4305 DST 4299-4370open 1 hr. Rec. 990' sw DST 4550-91open 1 hr. Rec. 1530' sw 1330#DST 4910-58 open 1 hr. Rec. 1173' sw1600# DST 5072-5105 open 2 hr.Rec. 125' vhoem 270' sw 1215#DST 5069-84 open $1\frac{1}{2}$ hr. Rec. 40' hoem135# DST 5147-92 open 1 hr. Rec. 55'mud 1335# DST 5187-5242 open 1 hr.Rec. 11' mud 0# DST 5398-5418

J. G. Meade

Drlg. Data

open 1 hr. Rec. 15' mud DST 5626-90
 open 1 hr. Rec. 70' gcm DST 5808-16
 open 1 hr. Rec. 20' sgcm TD 6000
 5" @ 5671 DST 5556-74 open $\frac{1}{2}$ hr.
 Rec. 55' gcm 2 mcfg 1845# DST 5555-91
 open 1 $\frac{3}{4}$ hr. Rec. 155' gcm 4,370,000 g
 1750# DST 5590-5626 open $1\frac{1}{4}$ hr.
 Rec. 70' gcm scum oil 582,000 gas 1670#
 DST-5808-16 open 1 hr. Rec. 20' sgcm
 O# TD 5995 5" @ 5671 PB 5640
 42/ 5619-26 $3\frac{1}{2}$ mcfg 42/ 5619-26
 500 A PB 5615 12/ 5603-05 60/ 5572-82
 $1\frac{1}{2}$ mcfg & SW 500 A 41/ 5572-82
 1,913,000 gas 48/ 5560-72 60/ 5582-97
 sd-frac 5560-97 Marm. 5075
 Marm. sd. 5559 Chester 5620
 St. Gen. 5838 Comp. 8,755,000 gas

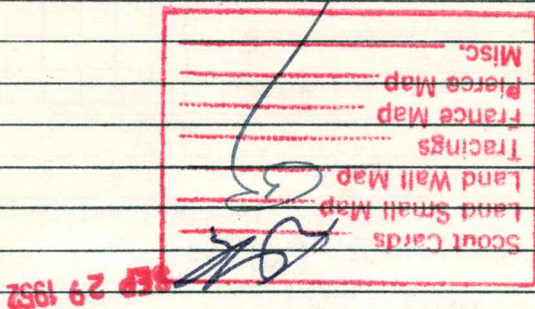

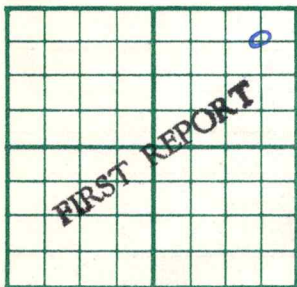County Moade State KansasSec. 32 (Blk. 32 (Sur. 30W Map No. 30W)Operator Columbian FuelWell No. 1 Farm C. E. StevensElev. Location C NE NE660 Ft. From N Line NE660 Ft. From E Line Quarter1st. Report JUN 25 1952

Completion

Remarks Sinclair -DHMPhillips \$ 4000. Skelly
\$ 7000.Spudding Date 6-23-52

Drlg. Data MCPC has E $\frac{1}{2}$ & SW/4 of 19, N $\frac{1}{2}$ of 34-
32-30W and NW/4 of 5-33-30W Wildcat
13" @ 505 WOC

J. G. McGEHEE

Scout Cards

Land Small Map

Land Wall Map

Tracings

France Map

Pierce Map

Misc.

JUN 27 1952

Orig. Data