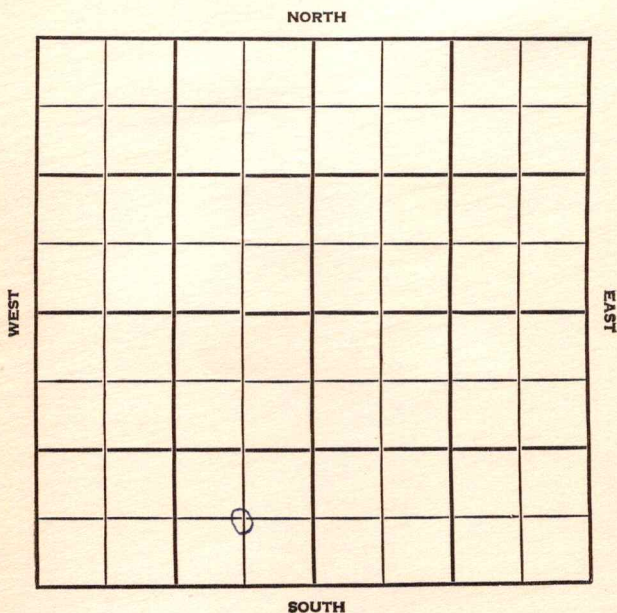


Section 35 Township 32 Range 30WWell No. #9 HolmesCompany Colorado O & G

Meade

KANSAS

SEC.

TWP.

R.

35

32

30W

WELL NO.

#9 Holmes

FARM

COMPANY

Colorado ~~####~~ O&G

CONTRACTOR

Leslie


____ FT. FROM N. LINE

____ FT. FROM S. LINE

____ FT. FROM E. LINE

____ FT. FROM W. LINE

C SE SW

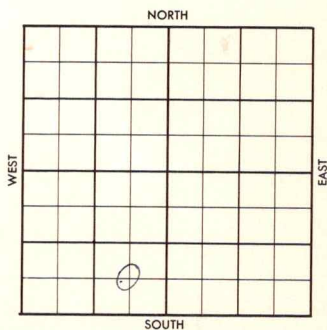

ELEVATION

1956

2735'

REPORT

8-22

Comm. 8-12-56

8" @ 1622 w/800

Drlg. 3395'

County Meade Elev. 2735
 Sec. 35 Twp. 32 Rgs. 30W
 Company Colorado O & G
 Farm Name Holmes No. 9

TOPS	DEPTH	LOG	DATUM	Loc. in Sec.
Anh.				C SE SW
Tr.				
H.				
Tr.				
Dg.				
Bl.				
L.				Geol.
K.C.				Contr.
B.K.C.				
Ce.				
C.				
M.				
M.				
K.				Pool
Mz.				Leslie
Me.				
V.				
S.				
S.				
A.				
R.				
Pe.				
G.				
T.D.				

FIRST REPORT
 AUG 22 '56
 0

Date Comm. 8-12-56
8" @ 1622/800 drlg. 3395

35
2201 P S QUA
R. G. R.

County	Meade	Elev.	2735
Sec.	35	Twp.	32
		Rge.	30W
Company	Colorado O & G		
Farm Name	Holmes	No.	9

TOPS	DEPTH	LOG	DATUM	Loc. in Sec.
Anh.				C SE SW
TP.				
H.				
Tr.				
Dg.				
Bl.				
L.		4538		
K.C.	Marm	5152		Geol.
B.K.	MW FORM	5621		Contr.
Ce.	" 3d	5646		
C.	chest	5681		
M.				
M.				Pool
K.				Leslie
Mz.				
Mo.				
V.				
S.				
S.				
A.				
R.				
PE.				
G.				
TD.	5810	5812		

COMPLETE

OCT 17 '56

Date Comm. 8-12-56

8" @ 1622/800 drlg. 3395 AUG 29 '56

1D 4824 SEP 15 '56 SEP 12 '56 CRD 5667
 - 92 rec 25' N.S. CRD 5692-5718
 rec 26' N.S. 5 1/2 @ 5797/300 AN
 20 PF chest 16/ 5750-54
 120/5713-43 & dry Frac (3)
 tst SSG + spray oil 16/11 SEP 19 '56
 est ga. 6. Mill + Light oil sp. ga
 7 Mill + est 80 BFPd (16% Acid w/

Frac 20 x 10 ga 16,400 MCF
+ 550 ga 13,200 MCF + sp.
oil 2" T69 @ 5718 SEP 26 '56 OCT 3 '56
ga 13,200 MCF + 6 To 8
dist.
B~~2~~ + Mill. OCT 10 '56 OCT 17 '56
est deliv. 3,500 MCF
+ 20 Barrells dist