

SECTION 29 TOWNSHIP 32 RANGE 30W

WELL NO. #1 H. A. Holmes "A"


COMPANY Shamrock

NORTH

SE SE NE

WEST

EAST

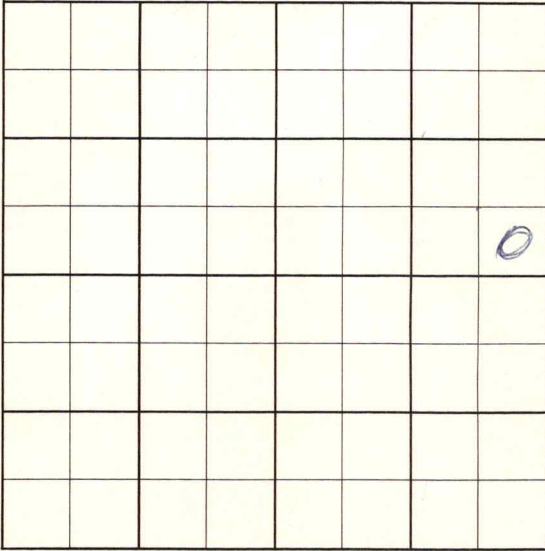

SOUTH

23

FORM 513 SUNRAY

County Meade Elev. 2764 DF
 Sec. 29 Twp. 32 Rge. 30W
 Company Shamrock
 Farm Name H. A. Holmes "A" No. 1

TOPS	DEPTH	LOG	DATUM
Anb.			
Tp.			
H.			
Tr.			
Dg.			
Bl.			
L.			
K.C.			
B.K.C.			
Ce.			
C.			
M.			
M.			
K.			
Mz.			
Ma.			
V.			
S.			
S.			
A.			
R.			
PE.			
G.			
T.D.			

Loc. in Sec. SE SE NE
 Geol. _____
 Contr. _____
 Pool Stevens-Leslie

ABANDONED
 SEP 18 57

Date Comm.

Location MAY 29 '57 JUN 5 '57 JUN 12 '57 JUN 19 '57 JUN 26 '57
 JUL 3 '57 JUL 10 '57 JUL 17 '57 JUL 24 '57 JUL 31 '57 AUG 8 '57
 AUG 14 '57 AUG 21 '57 AUG 28 '57 SEP 4 '57 SEP 11 '57
 SEP 18 '57

abandoned

Co.
Sec.
No.
Sec.
T.
R.

County Meade Elev. 2764
 Sec. 29 Twp. 32 Rge. 30W
 Company Shanrock
 Farm Name H. A. Holmes "A" No. 1

TOPS	DEPTH	LOG	DATUM
Anh.			
Tp.			
H.			
Tr.			
Dg.			
Bl.			
L.			
K.C.			
B.K.C.			
Ce.			
C.			
M.			
M.			
K.			
Mz.			
Ma.			
V.			
S.			
S.			
A.			
R.			
Pe.			
G.			
T.D.			

Loc. in Sec. _____

SE SE NE

Geol. _____

Contr. _____

Pool LESLIE

Stevens-Leslie

FIRST REPORT		
		6
		MAY 22 '57

Date Comm. _____

Location

35

Co.

Sec.

No.

Sec.

T.

R.