


Section 31 Township 32 Range 30 W

Well No. # 1 Stevens "B"

Company Columbian Fuel Corp.

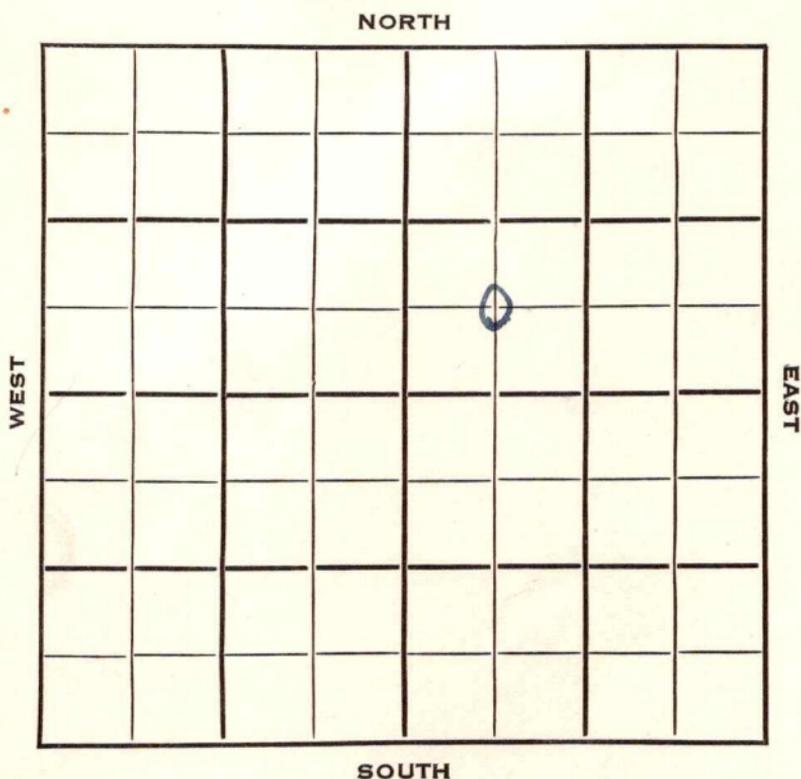

Meade KANSAS

SEC. 31 TWP. 32 R. 30 W ✓

WELL NO.

1 Stevens "B"

FARM

COMPANY

Columbian Fuel Corp.

CONTRACTOR

Mid-Western


_____ Ft. from N. Line

660 _____ Ft. from S. Line

_____ Ft. from E. Line

660 _____ Ft. from W. Line

C SW NE

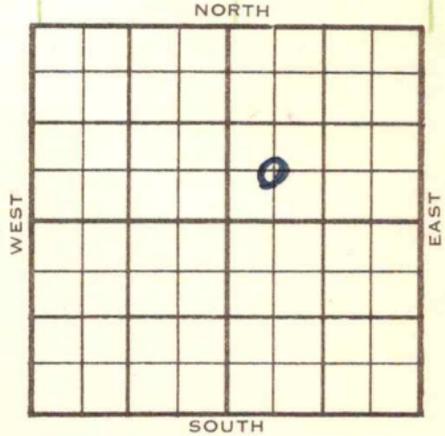

MCPC has NW of 5-33-30W

	ELEVATION	REPORT
1953	2769'	
11/18	Spud 11-12-53 13" @ 606 Drlg. 1925'	
12/16	D & A	
12/30	Spud 11-12-53 D&A TD 5715' 13" @ 606' Anhy 1520', Kri 2715', Win 2760', Ft. Riley 2880', F. Flint 2930' 9" @ 2680' Lans 4485' DST 5567-97', opn 1 hr., rec. 185' sgcmsw, 1700# DST 5588-5641', opn 1½ hrs., rec. 105' soc drlg. mud, 300# TD 5715 Marm. 5108', Cherokee 5263', Atoka 5368', Morrow 5579', Chester 5632' D&A	

ABANDONED

5579
2769

2810

County Meade State Kansas

Sec. 31 (Blk. Twp.) 32 (Sur. Rge.) 30W Map No.

Operator Columbian Fuel Corp.

Well No. 1 Farm Stevens "B"

Elev. 2769 Location C SW NE



660Ft. From S Line NE

660Ft. From W Line Quarter

Ist. Report

Completion DEC 20 1953

Remarks

Mid-Western - Contr.

Spudding Date 11-12-53

Drlg. Data D & A TD 5715

13" @ 606 Anhy 1520 Kri. 2715

Win. 2760 Ft. Riley 2880 F. flint 2930

9" @ 2680 Lans. 4485 DST 5567-97

open 1 hr. Rec. 185' sgcmw 1700#

DST 5588-5641 open 1½ hr. Rec. 105'

soc drlg. mud 300# TD 5715

Marm. 5108 Cherokee 5263 Atoka 5368

Morrow 5579 Chester 5632

D & A

