

Meade

KANSAS

33

32


30W

SECTION _____ TOWNSHIP _____ RANGE _____

#1 Bender

WELL NO. _____

COMPANY _____ Champlin O&R

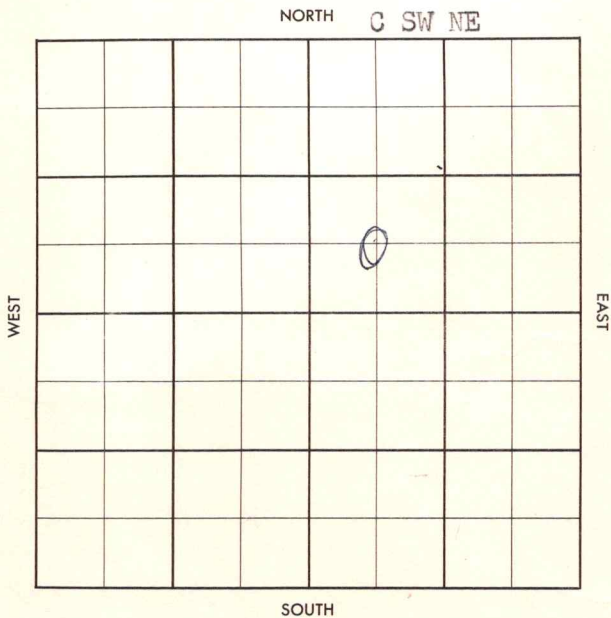

County Meade

Elev. _____

Sec. 33Twp. 32Rge. 30WCompany Champlin O & RFarm Name BenderNo. 1

TOPS

DEPTH

LOG

DATUM

Loc. in Sec. _____

Anh. _____

T.p. _____

H. _____

Tr. _____

Dg. _____

B.L. _____

L. _____

K.C. _____

B.K.C. _____

Ce. _____

C. _____

M. _____

M. _____

K. _____

Mz. _____

Mq. _____

V. _____

S. _____

S. _____

A. _____

R. _____

Pc. _____

G. _____

T.D. _____

C SW NE

Geol. _____

Contr. _____

Wakefield Tl. _____

Pool LESLIE

Stevens

FIRST REPORT			

Date Comm. 3-5-57

Drlg. _____

35

Co.

County MeadeElev. 2752Sec. 33Twp. 32Rge. 30WCompany Champlin O & RFarm Name BenderNo. 1

TOPS	DEPTH	LOG	DATUM	Loc. in Sec.
Anb.				C SW NE
Tr.				
H.				
Tr.				
Dg.				
Bl.				
L. <u>4496</u>	<u>4502</u>			
K.C.				Geol.
B.K.C.	<u>5070</u>			Contr.
Ce.				
C. <u>Marm</u>	<u>5100</u>			Wakefield Tls.
M. <u>ce</u>	<u>5300</u>			
M. <u>" 5d</u>	<u>5587-91</u>			Pool <u>LES415</u>
K. <u>MW 54</u>	<u>5597</u>			Stevens
Mz. <u>" 5d</u>	<u>5649-53</u>			
Mo. <u>" "</u>	<u>5658-62</u>			
V. <u>chest</u>	<u>5664</u>			
S.				
S.				ABANDONED
A.				
R.				
Pe.				
G.				
T.D.	<u>5750</u>			APR 10 '57

Date Comm. 3-5-57

Twp.

No.

Sec.

T.

R.

Drlg. MAR 13 '57 85/8 1813/12002665 10 4215 MAR 27 '57 SD @4764 APR 3 '57 DST 5583-97 gr 2hues. res. 30' Md All press.DST 5583-5672 2 hues @ 1/16 55"TSTM res. 300' 6 CM 310/30"10 ahead APR 10 '57DEA