


Section 33 Township 3 2 Range 30W

Well No. #1 Herman "A"

Company Phillips Petroleum

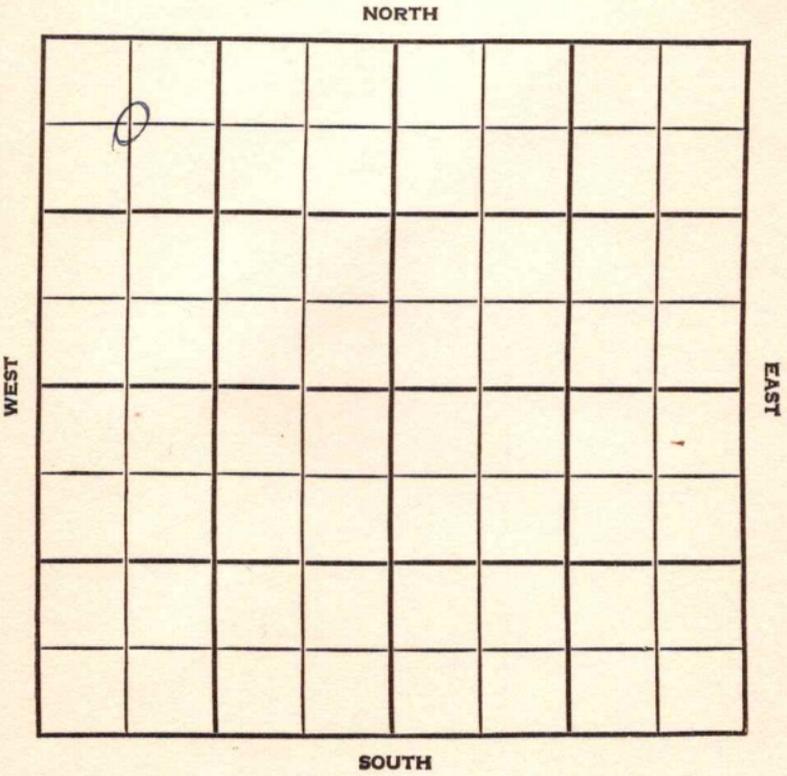

County Meade Elev. 2754
 Sec. 33 Twp. 32 Rge. 30W
 Company Phillips Petroleum
 Farm Name Herman "A" No. 1

Co.

TOPS	DEPTH	LOG	DATUM
Anh. <u>How</u>		<u>3931</u>	
TP. <u>E19</u>		<u>3938</u>	
H. <u>4354</u>		<u>4331</u>	
Tr.		<u>4369</u>	
Dg.			
Bl.			
L. <u>4473</u>		<u>4474</u>	
K.C. <u>DRUM</u>	<u>4720</u>		
B.K.C. <u>5039</u>		<u>5035</u>	
Ce. <u>Marm</u>	<u>5047</u>	<u>5044</u>	
C. <u>ce</u>	<u>5272</u>	<u>5270</u>	
M. <u>Keyes</u>	<u>5571</u>	<u>5572</u>	
M. <u>Base Ky</u>	<u>5592</u>	<u>5592</u>	
K. <u>M122</u>	<u>5619</u>		
Mz. <u>CBST</u>	<u>5621</u>	<u>5621</u>	
Ma.			
V.			
S.			
S.			
A.			
R.			
PE.			
G.			
TD.	<u>5721</u>		

Loc. in Sec. C NW NW
5600' test

Geol. _____
 Contr. _____
 Pool Leslie

0	
COMPLETE	
JAN 16 '57	

Sec.

No.

Sec.

T.

R.

Date Comm.

Location NOV 7 '56 ✓ NOV 13 '56 11-10-56
ID 1900 NOV 21 '56 858 1804/875
ID 4157 NOV 28 '56 ID 5404 DEC 5 '56
DST 5573-5600 30" 6 1/2" ga 4,640
MCF/15" 5,200 MCF= /30" FP 430
-675 BHP 1680 /20" DST 5630-70
1hr 30' Md BHP 20/20" RA9 542
DEC 12 '56 ✓ DEC 19 '56 5 1/2 @ 5699/75
PF 5574-90 /12" ga 2,600 MCF

ga 2,700 MCF + 85 G. DIST in
 8 hrs ^{DEC 26 '56} Frac ^{JAN 2 '57} ga
 6,360 MCF S.I. 16 1/2 hrs SIT
 1440 # Flwd 7,10 MCF FTP
 420 CP 1040 # ^{JAN 9 '57} ga.
 9,600 MCF + 296 gal dist
 in ~~8~~ hrs ^{JAN 15 '57} ga. 9,600
 MCF + 296 Gal. dist in 6 hrs
 complete for Gas wells.