



# HOT FILE

Meade

KANSAS

SEC. 34 TWP. 32 R. 30 W

WELL NO.

# 1 Behnke-Vail

FARM

COMPANY


(DEVELOPMENT-OB<sup>OC</sup>)

Carter & Sunray Mid-Cont.

CONTRACTOR

Leslie Field

\_\_\_\_\_ FT. FROM N. LINE  
 990 \_\_\_\_\_ FT. FROM S. LINE  
 \_\_\_\_\_ FT. FROM E. LINE  
 990 \_\_\_\_\_ FT. FROM W. LINE  
 of SW/4  
 NE SW SW

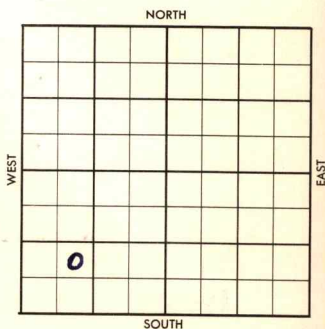

ELEVATION

1956

2747'

REPORT

5700' Morrow Test

- 8/22 MIM (FR. Tkt)
- 8/29 MIRT (DR#169)
- 8/30 "
- 8/31 Spudded 8-22-56  
Drlg. 3270'
- 9/4 TD 3270'. NR
- 9/5 Drlg. 4105'
- 9/6 TD 4105' NR
- 9/7 Drlg. 4562'
- 9/10 Drlg. 4744'
- 9/11 Drlg. 5320'
- 9/12 Drlg. 5476'
- 9/13 Drlg. 5618'
- 9/14 TD 5618' NR
- 9/17 Drlg. 5788'
- 9/18 TD 5800'. WOC - 5 1/2" @ 5797'
- 9/19 TD 5800'. WOC - 5 1/2" csg.
- 9/20 TD 5800' MORT
- 9/21 TD 5800' MICT
- 9/24 TD 5800'. Prep to perf.
- 9/25 TD 5800'. Testing perms 5695-5707'  
& 5713-5735'
- 9/26 TD 5800'. " " OVER

1956  
 9/27 TD 5800'. Testing perfs 5695-5707  
 and 6713-~~72~~ 5735'  
 9/28 TD 5800'. " "  
 10/1 TD 5800'. " "  
 10/2 TD 5800'. " "  
 10/3 " " "  
 10/4 TD 5800'. Prep to test perfs. "  
 5619-5623', 5628-5632' & 5651-5658'  
 10/5 TD 5800'. Prep to frac perfs 5619-  
 5623', 5628-5632' & 5651-5658'  
 10/8 TD 5800'. Flowed @ 3000 MCF  
 Gas Day rate. Perfs 5619-5623',  
 5628-5632' & 5651-5658'  
 Morrow Zone. Complete (DR#196)

Co.

County Meade Elev. 2747  
 Sec. 34 Twp. 32 Rge. 30 W  
 Name Carter & Sunray Mid-Continent  
Behnke-Vail No. 1

TOPS	DEPTH	LOG	DATUM	Loc. in Sec.
Anh. <u>WFD</u>		<u>2776</u>		NE SW SW
Tp. <u>Continued</u>	<u>3190</u>			
H. <u>FT. Kelly</u>		<u>3232</u>		
Tr.	<u>4380</u>	<u>4386</u>		
Dg.				
Bl.				
L.	<u>4520</u>	<u>4506</u>		Jim Ralston Geol.
K. <u>Hodges</u>	<u>4954</u>	<u>4950</u>		
B.K. <u>Marshall</u>	<u>5124</u>	<u>5101</u>		Warren Contr. Bradshaw
Ce. <u>57</u>	<u>5336</u>	<u>5300</u>		
C. <u>Mussd</u>	<u>5660</u>	<u>5620</u>		
M. <u>Chester</u>	<u>5692</u>	<u>5674</u>		
M. <u>Mw sh</u>		<u>5604</u>		Pool Leslie
K.				
Mz.				
Mo.				
V.				
S.				
S.				
A.				
R.				
Pe.				
G.				
<u>T.D.</u>	<u>5800</u>			

Loc.

No.

Sec.

T.

R.

COMPLETE  
 OCT 17 '56  
 0

Date Comm.

M I M AUG 29 '56 8 - 22 - 56 8 3/8 1546  
 1900 1/2 2700 SEP 5 '56 1/2 3563 SEP 12 '56  
 Tops 1/2 5476 SEP 19 '56 Mussd 5660-75  
 DST 5656-85 open thru nec 15" 1/2 Md.  
 All press o chester 5692 (porous 20  
 5735-63) 1/2 5000 SEP 26 '56 ~~ST. PICR~~  
 RTD 5800 Ran Log St. Picr DST  
 5619-58 or 105" 8/3 1/2" ga  
 1.630 MCF/10" ga 1.790 MCF/20"

ga 1,860 MCF/30" ga 1 1/2 Mill.  
 @ end of tst. nec 120' GCM  
 +60' S salty GCM FP 315-215  
 BHP 1765/30" 5 1/2 @ 5797/250  
 MICT CO? GRNL PF 72/5201  
 -13 132/5719-41  $\wedge$  556/3

tst 196 MCF Frac 20 x 10 & Ld.

OCT 3 '56 X 24 hr BD ga. 1,630 MCF

SITP 75# + spray Load.

15 hr BD ga. 1,250 MCF 1/4" ch

FTP 175# 10 hr BD 1,250 MCF

1/2" ch FTP 175# 14 hr BD

1,20 MCF FTP 20# 24 hr BD

734 MCF FTP 20# Frac 10 x 10

ga 98 MCF G + Ld 24 hrs

well wouldn't flow ga.

76 MCF G + Ld 24 hrs, tst g.

OCT 10 '56

X (PB) 5685 PF 24/5619-23

24/5628-32 28/5651-58 Rng

769 & Pkr. OCT 17 '56 X Frac 10 x 10

ga Flow Ld + ga 3. Mill CFB

1/2" ch FTP 225 FCP 445#

Flow Ld + ga 1,020 MCF 1/2" ch

FTP 160 FCP 310# St. 2 1/2 hrs

Flow Ld + 1,020 MCF SITP 610

SICP 650#

Calc of Flow 1,266 MCF G P

SITP 610 CP 700#

NO

FORM 513 SUNRAY

County Meade Elev. 2747

Sec. 34 Twp. 32 Rge. 30 W

Company Carter & Sunray Mid-Continent

Farm Name Behnke-Vail No. 1

TOPS	DEPTH	LOG	DATUM
Anh.			
Tp.			
H.			
Tr.			
Dg.			
Bl.			
L.			
K.C.			
B.K.C.			
Ce.			
C.			
M.			
M.			
K.			
Mz.			
Me.			
V.			
S.			
S.			
A.			
R.			
Pe.			
G.			
T.D.			

Loc. in Sec. NE SW SW

Geol. \_\_\_\_\_

Contr. \_\_\_\_\_

Pool Leslie

FIRST REPORT

AUG 22 '56

Date Comm.

M I M

*Handwritten red scribble*

NOV 5 1956

M.M.

Co.

Lse.

No.

Sec.

T.

R.