


SECTION 36 TOWNSHIP 32 RANGE 30W

WELL NO. #2 Bachman

COMPANY Peerless O&G

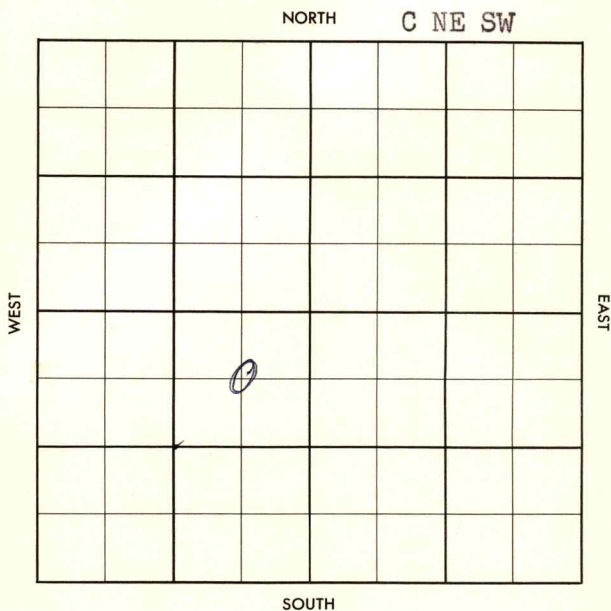

Flw 308 Bopd 15 hrs 5940
7,766 Bopd 24 hrs 34/64"
ch. (B.H. Bomb + st)
SITP 1575 #

County Meade Elev. _____
 Sec. 36 Twp. 32 Rge. 30W
 Company Peerless O & G
 Farm Name Bachman No. 2

TOPS	DEPTH	LOG	DATUM	Loc. in Sec.
Anh.				C NE SW
Tp.				
H.				
Tr.				
Dg.				
Bl.				
L.				Geol. _____
K.C.				Contr. _____
B.K.C.				Midwestern
Ce.				Pool
C.				Stephens
M.				Leslie
M.				<div style="border: 1px solid black; padding: 5px; text-align: center;"> <p>FIRST REPORT</p> <p>MAY 1 1957</p> </div>
K.				
Mz.				
Me.				
V.				
S.				
S.				
A.				
R.				
PE.				
G.				
T.D.				

Date Comm. 4-29-57

~~25~~

Co. Lse. No. Sec. T. R.