


SECTION 36 TOWNSHIP 32 RANGE 30W

WELL NO. #4 Bachman

COMPANY Peerless

NORTH C SE NW

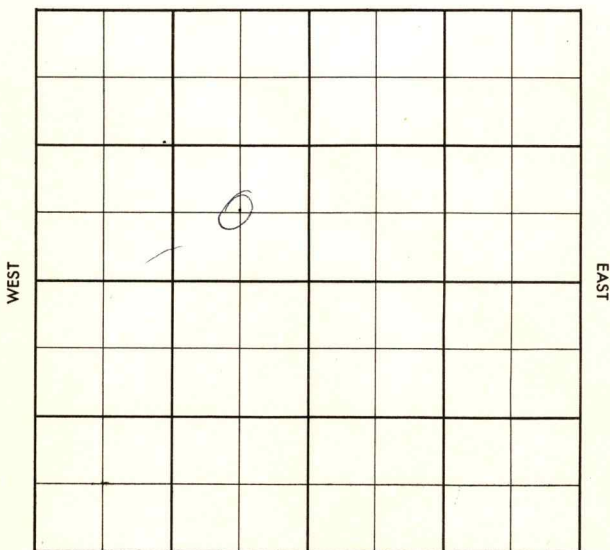

SOUTH

County Meade Elev. _____
 Sec. 36 Twp. 32 Rge. 30W
 Company Peerless
 Farm Name Bachman No. 4

TOPS	DEPTH	LOG	DATUM
Anh.			
Tp.			
H.			
Tr.			
Dg.			
Bl.			
L.			
K.C.			
B.K.C.			
Ce.			
C.			
M.			
M.			
K.			
Mz.			
Mq.			
V.			
S.			
S.			
A.			
R.			
Pe.			
G.			
T.D.			

Loc. in Sec. C SE NW
 Geol. _____
 Contr. _____
Midwestern Tool
 Pool Leslie

FIRST REPORT
 JUN 12 '97

Date Comm. _____

Location _____

Handwritten red scribbles

Co.
 Lse
 No.
 Sec.
 T.
 R.

