

STATE CORPORATION COMMISSION OF KANSAS
OIL & GAS CONSERVATION DIVISION
WELL COMPLETION OR RECOMPLETION FORM
ACO-1 WELL HISTORY
DESCRIPTION OF WELL AND LEASE

Operator: License # 3711
Name Shepler & Thomas, Inc.
Address P.O. Box 1162
City/State/Zip Liberal, KS 67905-1162

Purchaser N/A

Operator Contact Person R. F. Burke
Phone (316) 624-0750

Contractor: License # 3098
Name Exeter Drilling

Wellsite Geologist Don Huber
Phone (316) 624-8222

Designate Type of Completion

New Well Re-Entry Workover
 Oil SWD Temp Abd
 Gas Inj Delayed Comp.
 Dry Other (Core, Water Supply etc.)

If OWWO: old well info as follows:

Operator
Well Name
Comp. Date Old Total Depth

WELL HISTORY

Drilling Method:

Mud Rotary Air Rotary Cable

1-20-89 1-29-89
Spud Date Date Reached TD Completion Date

6000 5639
Total Depth PBTD

Amount of Surface Pipe Set and Cemented at 1620.53 feet

Multiple Stage Cementing Collar Used? Yes No

If yes, show depth set feet
If alternate 2 completion, cement circulated from feet depth to w/SX cmt
Cement Company Name
Invoice #

API NO. 15-175-21,076

County Seward

SW NW Sec. 29 Twp 32S Rge 31 East West

3300 Ft North from Southeast Corner of Section
4620 Ft West from Southeast Corner of Section
(Note: Locate well in section plat below)

Lease Name Siemens Well # 1-29

Field Name N/A


Producing Formation N/A

Elevation: Ground 2783 KB 2794

Section Plat

KANSAS GEOLOGICAL SURVEY
WICHITA BRANCH
MAY 12 1989

RECEIVED
STATE CORPORATION COMMISSION
MAY 11 1989
CONSERVATION DIVISION
Wichita, Kansas

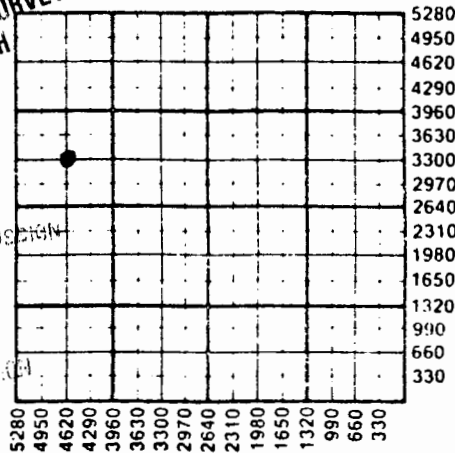

WATER SUPPLY INFORMATION

Disposition of Produced Water: Disposal
Docket # Repressuring

Questions on this portion of the ACO-1 call:
Water Resources Board (913) 296-3717

Source of Water:
Division of Water Resources Permit #

Groundwater Ft North from Southeast Corner
(Well) Ft West from Southeast Corner of
Sec Twp Rge East West

Surface Water Ft North from Southeast Corner
(Stream, pond etc) Ft West from Southeast Corner
Sec Twp Rge East West

Other (explain) Irrigation Well
(purchased from city, R.W.D. #)

INSTRUCTIONS: This form shall be completed in triplicate and filed with the Kansas Corporation Commission, 200 Colorado Derby Building, Wichita, Kansas 67202, within 120 days of the spud date of any well. Rule 82-3-130, 82-3-107 and 82-3-106 apply.

Information on slide two of this form will be held confidential for a period of 12 months if requested in writing and submitted with the form. See rule 82-3-107 for confidentiality in excess of 12 months. One copy of all wireline logs and drillers time log shall be attached with this form. Submit CP-4 form with all plugged wells. Submit CP-111 form with all temporarily abandoned wells.