

STATE CORPORATION COMMISSION OF KANSAS
OIL & GAS CONSERVATION DIVISION

WELL COMPLETION OR RECOMPLETION FORM
ACO-1 WELL HISTORY

DESCRIPTION OF WELL AND LEASE

Operator: License # 3711
Name Shepler & Thomas, Inc.
Address P.O. Box 1162
City/State/Zip Liberal, Kansas 67906-1162

Purchaser: N/A

Operator Contact Person R. F. Burke
Phone (316) 624-0750

Contractor: License #
Name Beredco Drilling Company

Wellsite Geologist Tom Robinson
Phone

Designate Type of Completion

☒ New Well ☐ Re-Entry ☐ Workover
☐ Oil ☐ SWD ☐ Temp Abd
☐ Gas ☐ Inj ☒ Delayed Comp.
☐ Dry ☐ Other (Core, Water Supply etc.)

If OWWO: old well info as follows:

Operator
Well Name
Comp. Date Old Total Depth

WELL HISTORY

Drilling Method:

☒ Mud Rotary ☐ Air Rotary ☐ Cable
3-18-88 3-29-88 N/A
Spud Date Date Reached TD Completion Date
6000 5960
Total Depth PBDT

Amount of Surface Pipe Set and Cemented at 1599 feet
Multiple Stage Cementing Collar Used? ☐ Yes ☒ No
If yes, show depth set feet
If alternate 2 completion, cement circulated from feet depth to w/ SX cmt

API NO. 15-175-21019

County Seward

SW SE Sec 33 Twp 32S Rge 31 ☐ East ☒ West

660 Ft North from Southeast Corner of Section
1980 Ft West from Southeast Corner of Section
(Note: Locate well in section plat below)


Lease Name Kulp Well # 1-33

Field Name N/A

Producing Formation Unknown

Elevation: Ground 2778 KB 2790

Section Plat

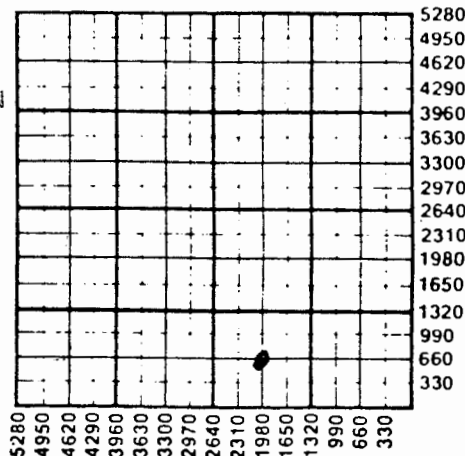

WATER SUPPLY INFORMATION

Disposition of Produced Water: ☐ Disposal
Docket # ☐ Repressuring

Questions on this portion of the ACO-1 call:

Water Resources Board (913) 296-3717

Source of Water:
Division of Water Resources Permit # TL88162

☐ Groundwater 560 Ft North from Southeast Corner
(Well) 1830 Ft West from Southeast Corner of
Sec 33 Twp 32S Rge 31 ☐ East ☒ West

☐ Surface Water Ft North from Southeast Corner
(Stream, pond etc) Ft West from Southeast Corner
Sec Twp Rge ☐ East ☐ West

☐ Other (explain)
(purchased from city, R.W.D. #)

INSTRUCTIONS: This form shall be completed in duplicate and filed with the Kansas Corporation Commission, 200 Colorado Derby Building, Wichita, Kansas 67202, within 90 days after completion or recompletion of any well. Rule 82-3-130 and 82-3-107 apply.
Information on side two of this form will be held confidential for a period of 12 months if requested in writing and submitted with the form. See rule 82-3-107 for confidentiality in excess of 12 months.
One copy of all wireline logs and drillers time log shall be attached with this form. Submit CP-4 form with all plugged wells. Submit CP-111 form with all temporarily abandoned wells.

All requirements of the statutes, rules and regulations promulgated to regulate the oil and gas industry have been fully complied with and the statements herein are complete and correct to the best of my knowledge.

Signature R. F. Burke
Title Agent Date 7-11-88

Sharon E. Freeman
Notary Public
Date Commission Expires 01-04-91

KANSAS GEOLOGICAL SURVEY
WICHITA BRANCH

Form ACO-1 (7-84)

K.C.C. OFFICE USE ONLY		
☒	Letter of Confidentiality Attached	
☒	Wireline Log Received	
☐	Drillers Timelog Received	
Distribution		
☐	KCC	☐ SWD/Rep
☒	KGS	☐ Plug
		☐ NGPA
		☐ Other
(Specify)		

Sec. Twp. Rge.

11 1988