


Section 28 Township 32 Range 31W

Well No. 1 Collingwood

Company Musgove Petr.

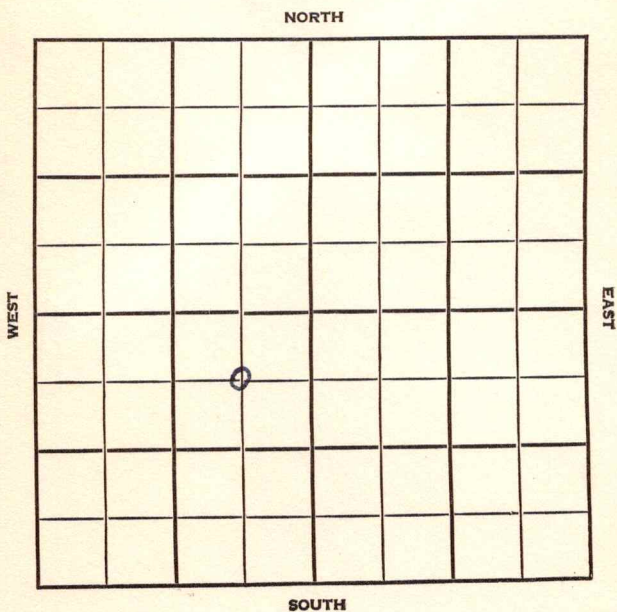

HOT FILE

Seward KANSAS


SEC.	TWP.	R.
28	32	31W

WELL NO. 1 Collingwood FARM

COMPANY Musgrove Petr.

CONTRACTOR Musgrove

660 Ft. from N. Line
 Ft. from S. Line
 660 Ft. from E. Line
 Ft. from W. Line

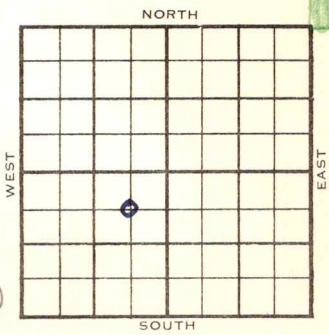

C NE SW E1. 2798 (L+S)

PEPL FO
 MCPC has S/2 & NE 1/4 OF 22 & SE 1/4 of 34

195 ELEVATION REPORT

Miss Test

4/20 Spud 4-17-55
 4/28 8" @ 2719
 DST 2715-55 open 1 hr rec 15' mud. Off
 Drlg. 3000' (Ltr-Gilstrap)

5/25 Winf 2751; Tow 2807; Heeb 4282;
 Tor 4303; Ft. Riley 2868;
 Lgs 4397; Marm 5040; Wref 2978;
 Coun Gr 3013, Wab 3431; Top 3952;
 Heeb 4284; Tor 4302; Lgs 4401
 Marm 5040; Chero 5224; Morr Sh 5538;
 Miss 5612;
 TD 5775; 13" 578; 8 5/8 2719;
 DST 2715-55 open 1 hr rec 15' mud Off
 DST 3020-80 open 1 hr rec 190' muddy
 wtr 629#
 DST 3632-86 open 1 hr, rec 450' Msw
 1635' sw 1010#;
 DST 4303-4400 open 1 hr gauge 76,000
 cfg 15 min, 2200; 22,000 cfg 20 min,
 rec 515' sw, 45' gscm, 380#;
 DST 4420-4504; open 1 hr rec 2400'
 sw, 1360#
 DST 5043-90 open 1 hr rec 30' sgcm, 2
 2750#; DST 5518-60 open 1 hr, rec 45'
 mud, 100#, DST 5572-5620 open 90 min
 rec 20' mud 75# Schlum **ABANDONED**

County **Seward** State **Kansas**

Sec. **28** (Blk. Twp.) **32** (Sur. Rge.) **31W** Map No.

Operator **Musgrove Pet.**

Well No. **1** Farm **Collingwood**

Elev. Location **C NE SW**

FIRST REPORT

660 Ft. From **N** Line **SW**

660 Ft. From **E** Line Quarter

1st. Report **APR 20 1955**

Completion

Remarks **Miss. test PEPL farmout**

Musgrove - Contr.

Spudding Date **4-17-55**

Drlg. Data **MCPC has S $\frac{1}{2}$ & NE $\frac{1}{4}$ of 22 & SE $\frac{1}{4}$ of 34**