

Seward

KANSAS

15

32

31W

SECTION _____ TOWNSHIP _____ RANGE _____

#1 Chapple

WELL NO. _____

Graham-Michaelis & SDX


COMPANY _____

NORTH

C SW/4

WEST

EAST

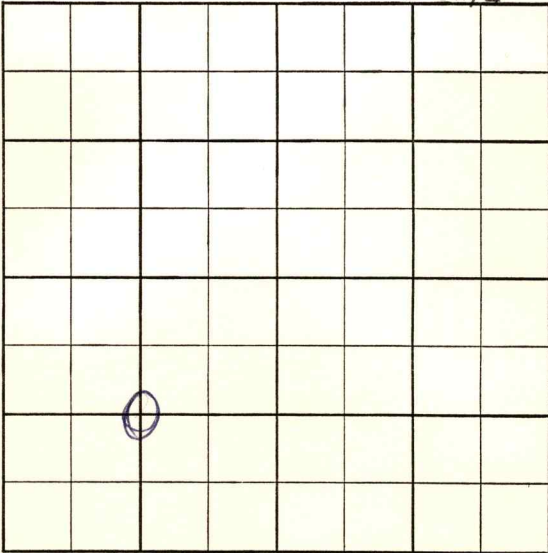

SOUTH

HOT FILE Seward KANSAS

SEC. 15 TWP. 32 S R. 31 W

WELL NO.

1 ~~Meyer~~ Chapple

COMPANY

FARM

CONTRACTOR Graham-Michaelis & SDX (DEVELOPMENT-OB OC)

Graham-Michaelis

Plains West

1320 FT. FROM N. LINE


FT. FROM S. LINE

FT. FROM E. LINE

1320 FT. FROM W. LINE

of SW/4

C SW/4

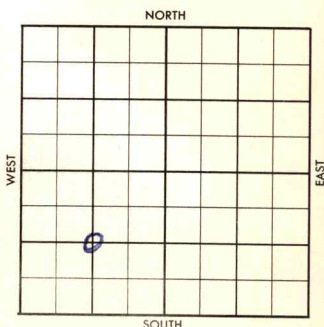

ELEVATION

1957

REPORT

5800' Miss. Test

11/11

Spudded 11-8-57

Drlg. 687' 8"@1495/800

(DR#220)

11/12

Drlg. 1592'

11/13

Drlg. 2520'

(FR Tkt)

11/14

Drlg. 2850'

11/15

Drlg. 3145'

11/18

Drlg. 3455'

11/19

Drlg. 4326'

11/20

TD 4326' NR

11/21

Drlg. 4749'

11/22

Drlg. 4909'

11/25

Drlg. 5102'

11/26

Drlg. 5500'

11/27

TD 5605'. DST 5581-5605'

12/2

TD 5720'. P & A

(DR#233)

S-512A

ABANDONED

ELEV 28050

15

TWP. 32

RGE. 31W

DEC 4 '57

COMPANY Graham-Michaelis No. 1

4 SDX

FARM Chapple

LOC. C SW/4

GEOL.

CONTR. Graham-Michaelis

POOL Plains West

SPUD 11-7-57

8" @ 1495/800

dril. 2520

NOV 20 '57

Ø 4537

Hb 4310 TR 4329

Lsg 4412 Ø 5500

DEC 4 '57 x Co 5277

MOT 5596 DST 5581 - 5650

60" reg 385' MCSW FP 190-220

BHP 1940-1800 ^{BACKTOP} MOT sd 5636~~5 J TOPS~~ Chester 5661

5 J TOPS RTD 5720

5 J TOPS ~~RTD~~ Hb 4308

TR 4328 L 4406 Mar m

5084 Co 5270 U MOT sd

5590 L MOT sd 5630

Chester 5650 LTD 5716

D-L A

CO. Seward ELEV. _____SEC. 15 TWP. 32 RGE. 31W **FIRST REPORT**COMPANY Graham-Michaelis 1
& SDXFARM ChappleLOC. C SW/4

GEOL. _____

CONTR. Graham-MichaelisPOOL Plains WestSPUD 11-7-578" @ 1495/800drlg. 2520

~~35~~