

STATE CORPORATION COMMISSION OF KANSAS  
OIL & GAS CONSERVATION DIVISION

WELL COMPLETION OR RECOMPLETION FORM  
ACO-1 WELL HISTORY

DESCRIPTION OF WELL AND LEASE

Operator: License # 5263  
Name ..... Midwestern Exploration Co.  
Address ..... P.O. Box 1884  
City/State/Zip ..... Liberal, Kansas 67905

\* Purchaser ..... Enron Gas Supply Co.  
Tulsa, Oklahoma

Operator Contact Person ..... Harold K. Frauli  
Phone ..... (316) 624-3534

Contractor: License # 5421  
Name ..... Sage Drilling Co.

Wellsite Geologist ..... Joe Blair  
Phone ..... (405) 366-7558

Designate Type of Completion  
 New Well  Re-Entry  Workover  
 Oil  SWD  Temp Abd  
 Gas  Inj  Delayed Comp.  
 Dry  Other (Core, Water Supply etc.)

If OWNO: old well info as follows:  
Operator .....  
Well Name .....  
Comp. Date ..... Old Total Depth.....

WELL HISTORY

Drilling Method:  
 Mud Rotary  Air Rotary  Cable  
9-9-88 9-18-88 10-16-88  
Spud Date Date Reached TD Completion Date  
6042' 2816'  
Total Depth PBD

Amount of Surface Pipe Set and Cemented at 1605 feet  
Multiple Stage Cementing Collar Used?  Yes  No  
If yes, show depth set.....feet  
If alternate 2 completion, cement circulated  
from.....feet depth to.....w/.....SX cmt

API NO. 15-.....175-21,041.....

County.....Seward.....  
250' West  
NW/4 NW/4 ..... Sec. 7 Twp. 32S Rge. 32  East  West

4620.... Ft North from Southeast Corner of Section  
4870.... Ft West from Southeast Corner of Section  
(Note: Locate well in section plat below)


Lease Name.....Printz.....Well #.....1-7.

Field Name.....Wildcat.....

Producing Formation.....Hugoton.....

Elevation: Ground.....2844.....KB.....2854

Section Plat

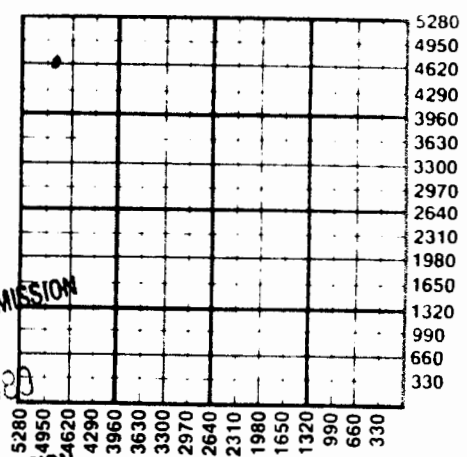

RECEIVED  
STATE CORPORATION COMMISSION  
JAN 25 1989  
CONSERVATION DIVISION  
Wichita, Kansas

WATER SUPPLY INFORMATION  
Distribution of Produced Water:  Disposal  Repressuring  
Docket # .....

Questions on this portion of the ACO-1 call:  
Water Resources Board (913) 296-3717

Source of Water:  
Division of Water Resources Permit #.....T 88-452.....

Groundwater.....4745 Ft North from Southeast Corner  
(Well) .....4895 Ft West from Southeast Corner of  
Sec 7 Twp 32S Rge 32  East  West

Surface Water.....Ft North from Southeast Corner  
(Stream, pond etc).....Ft West from Southeast Corner  
Sec Twp Rge  East  West

Other (explain).....  
(purchased from city, R.W.D. #)

INSTRUCTIONS: This form shall be completed in duplicate and filed with the Kansas Corporation Commission, 200 Colorado Derby Building, Wichita, Kansas 67202, within 90 days after completion or recompletion of any well. Rule 82-3-130 and 82-3-107 apply.  
Information on side two of this form will be held confidential for a period of 12 months if requested in writing and submitted with the form. See rule 82-3-107 for confidentiality in excess of 12 months.  
One copy of all wireline logs and drillers time log shall be attached with this form. Submit CP-4 form with all plugged wells. Submit CP-111 form with all temporarily abandoned wells.

All requirements of the statutes, rules and regulations promulgated to regulate the oil and gas industry have been fully complied with and the statements herein are complete and correct to the best of my knowledge.

Signature .....  
Title.....Agent.....Date 10-28-88

JAN 26 1989

Subscribed and sworn to before me this 28th day of October 1988.  
Notary Public.....  
Date Commission Expires.....

K.C.C. OFFICE USE ONLY  
 Letter of Confidentiality Attached  
 Wireline Log Received  
 Drillers Timelog Received  
Distribution  
 KCC  SWD/Rep  NGPA  
 KGS  Plug  Other  
(Specify)

Sec 7 Twp 32S Rge 32

