


Seward KANSAS

Section 20 Township 32 Range 32W

Well No. 1 Lambert

Company Prince Bros. Drlg. Co.

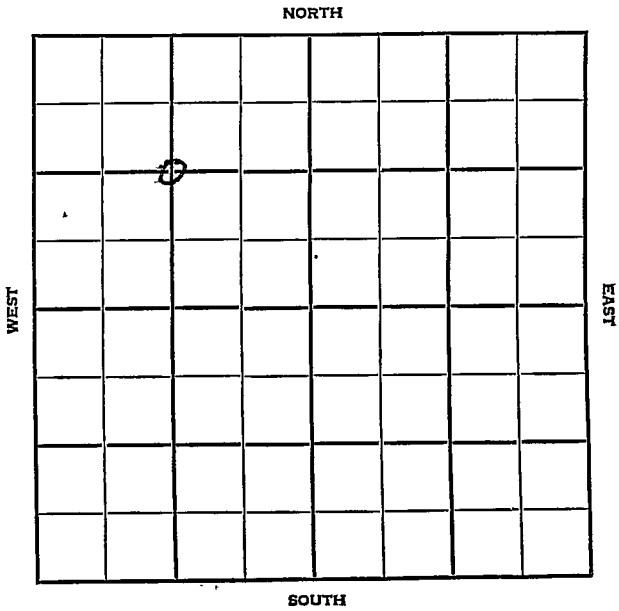

Seward KANSAS

SEC.	TWP.	R.
20	32	32W

WELL NO.

1 Lambert

FARM

COMPANY

Prince Bros. Drlg. Co.

CONTRACTOR

Co. Tools

Hugoton Pool

1320

Ft. from N. Line


Ft. from S. Line

Ft. from E. Line

1320

Ft. from W. Line

C NW/4

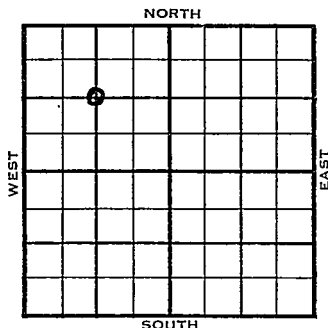

	ELEVATION	REPORT
1954	2844'	

9/15

Spud 9-7-54


10/20

Spud 9-7-54 Gas well TD 2722
 8" @ 545 Her. 2613 Kri. 2672
 Win. 2722 TD 2722 5" @ 2722
 CO to 2722 42/2678-85 500 M-A
 750,000 CFG SP 2664 60/2650-60
 60/2614-24 200,000 CFG dolo-frac.
 2,345,000 CFG 1 BSWPH
 Comp. 5,434,000 CFGPD 435#

COMPLETED

County Seward State Kansas
 Sec. 20 (Blk.) 32 (Sur.) 32W Map No.
 (Twp.) (Rge.)

Operator Prince Bros.
 Well No. 1 Farm Lambert
 Elev. 2844 Location C NW/4

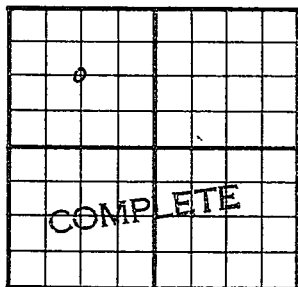

1320 Ft. From N Line NW
1320 Ft. From W Line Quarter
 1st. Report

Completion OCT 20 1954
 Remarks Hugoton Pool
Co. tools

Spudding Date 9-7-54

Drlg. Data Gas well TD 2722

8" @ 545 Her. 2613 Kri. 2672

Win. 2722 TD 2722 5" @ 2722

CO to 2722 42/ 2678-85 500 M-A

750,000 cfg SP 2664 60/ 2650-60

60/2614-24 200,000 cfg dolo-frac

2,345,000 cfg 1 bswph

Comp. 5,434,000 cfgcd 435#

FABEN GILSTRAP