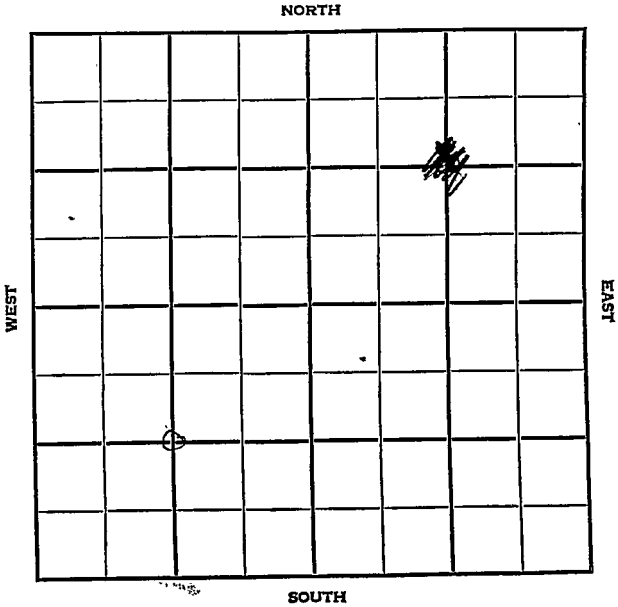


Section 21 Township 32 Range 32WWell No. #1 EmerickCompany Michaelis Drlg.

Seward KANSAS

SEC.	TWP.	R.
21	32	32W

WELL NO.

1 Emerick

FARM

COMPANY

Michaelis Drllg.

CONTRACTOR

Co. Tools

Hugoton Pool

Ft. from N. Line


1320

Ft. from S. Line

Ft. from E. Line

1320

Ft. from W. Line

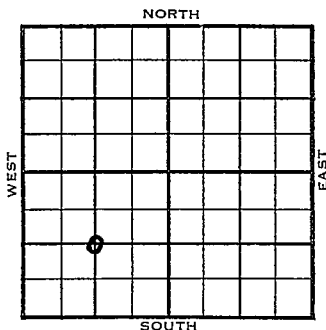

C SW/4

Northern Nat. FO

	ELEVATION	REPORT
1955	2830'	

4/13

Spud 4-7-55

8" @ 527'

TD 2730'

5" @ 2729', WOC

5/25

Spud 4-7-55 8" @ 527 w/300

TD 2730' 5" @ 2729 CO

Perf/2718-23 1000 A 280 MCFG

frac. 1,600 MCFG SP 2714

Perf/2670-90 2642-48 2606-16

frac. 1,784 MCFG SI 32 hr.

5,255 MCFG

Comp. 6,920 MCFGPD 432#

Tops: Herr 2607', Paddo 2624',


U. Kri 2640', L. Kri. 2669',

Odell 2703', Win 2717'

TD 2730' Comp. Gas

COMPLETED

County Seward State Kansas
 Sec. 21 (Blk.) 32 (Sur.) 32W Map No.
 Operator Michaelis Drlg.
 Well No. 1 Farm Emerick
 Elev. Location C SW/4

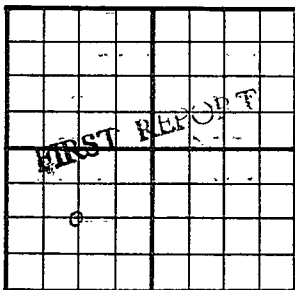

1320 Ft. From S Line SW
1320 Ft. From W Line Quarter
 Ist. Report APR 13 1955

Completion

Remarks Northern Nat. Farmout
Co. tools

Spudding Date 4-7-55

Drlg. Data Hugoton Pool

8" @ 527 TD 2730 5" @ 2729 WOC

FABEN GILSTRAP

COMPLETED

FORM 513 REV. SUNRAY

County Seward Elev. 2830
 Sec. 21 Twp. 32 Rge. 32W
 Company Michaelis Drlg.
 Farm Name Emerick No. 1

TOPS

DEPTH


DATUM

Cim. Anhydrite		
Fl. Riley <u>Herr</u>	<u>2607</u>	
Howard <u>Paddo</u>	<u>2624</u>	
Topeka <u>H. Kri</u>	<u>2640</u>	
Heebner Sh.		
Toronto ls. <u>L. Kr.</u>	<u>2669</u>	
Brown Lime		
Lansing <u>Odell</u>	<u>2703</u>	
Kans. City <u>Win</u>	<u>2717</u>	
B. K. C.		
Congl.		
Miss.		
Kinderhook		
Misener		
Hunton		
Sylv. Maquo		
Viola		
Simpson		
Smp.		
Gorham		
Arbuckle		
Basal Sand		
Pre. Cam.		
T. D.	<u>2730</u>	

Loc. in Section

C SW/4

Drlg. Contr.

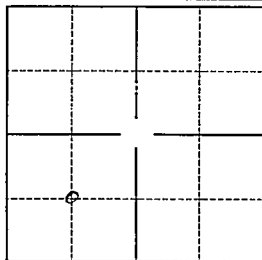Pool Hugoton

Date Comm.

Date Comp. MAY 25 '55

Spud 4-7-55 8" @ 527 w/ 300

TD 2730 5" @ 2729 CO perf/ 2718-24

1000 A 280 mcfg frac 1,600 mcfg

SP 2714 perf/ 2670-90 2642-48

2606-16 frac 1,784 mcfg SI 32 hr.

5,255 mcfg Comp. 6,920 mcfgpd 432#