


Section 28 Township 32 Range 32W

Well No. #1 Deffenbaugh

Company Draper Motor Corp.

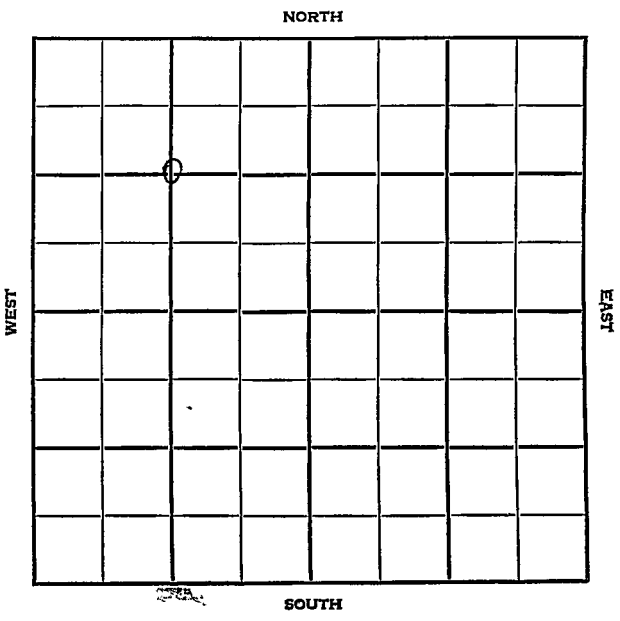

Seward

KANSAS

SEC.	TWP.	R.
28	32	32W

WELL NO.

#1 Deffenbaugh

FARM

COMPANY

Draper Motor Corp.

CONTRACTOR

Hugoton Pool

1320


Ft. from N. Line

Ft. from S. Line

Ft. from E. Line

1320

Ft. from W. Line

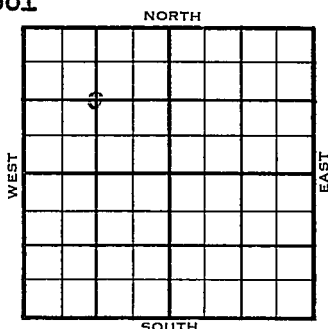

C NW/4

N. Nat. F/O

	ELEVATION	REPORT
1954	2826'	

12/1

Spud 11-20-54

8" @ 622'

TD 2630'

5" @ 2628'


1955

1/12

Spud 11-20-54 Gas well TD 2650'
 8" @ 622 Her. 2624 TD 2650 6000 A
 frac. 5750 A Comp. 1,770,000 GFGPD

COMPLETED

County Seward State Kansas
 Sec. 28 (Blk. Twp.) 32 (Sur. Rge.) 32W Map No.
 Operator Draper Motor Corp.
 Well No. 1 Farm Deffenbaugh
 Elev. _____ Location C NW/4

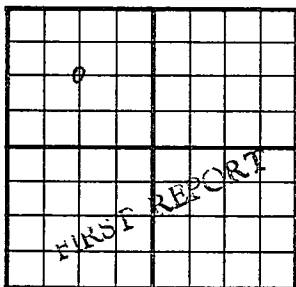


1320 Ft. From N Line NW
1320 Ft. From W Line Quarter
 Ist. Report DEC 1 1954
 Completion _____
 Remarks N. Nat. FO

Spudding Date 11-20-54

Drlg. Data Hugoton Pool

8" @ 622 TD 2630 5" @ 2628

FABEN GILSTRAP

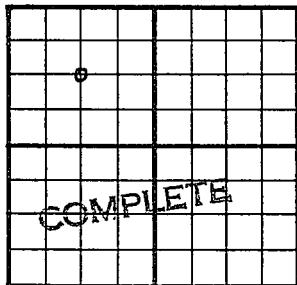County Seward State KansasSec. 28 (Blk.
Twp.) 32 (Sur.
Rge.) 32W Map No.Operator Draper Motor Corp.Well No. 1 Farm DeffenbaughElev. 2826 Location C NW/41320Ft. From N Line NW1320Ft. From W Line Quarter1st. ReportCompletion JAN 12 1955Remarks Hugoton PoolSpudding Date 11-20-54Drilg. Data Gas well TD 26508" @ 622 Her. 2624 TD 2650 6000 Afrac 5750 A Comp. 1,770,000 cf gpd

FABEN GILSTRAP