


Section 3 Township 32 Range 3 2W

Well No. 1 Wessler

Company Prince Bros.

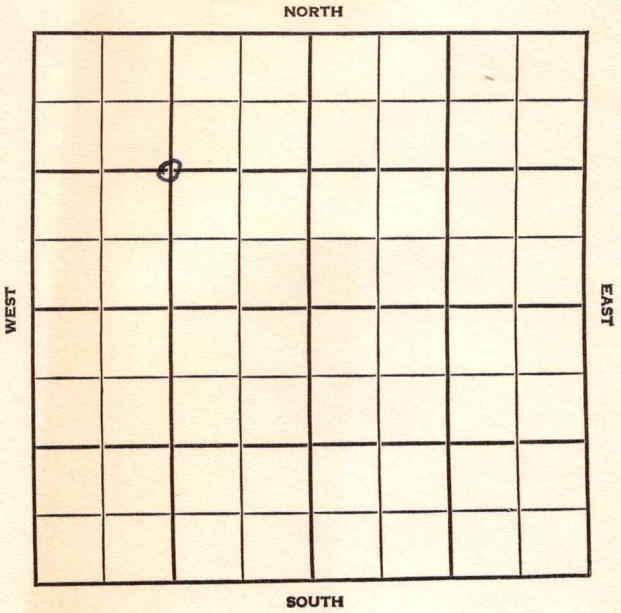

Seward **KANSAS**

SEC.	TWP.	R.
3	32	32W

WELL NO. **1 Wessler** FARM

COMPANY **Prince Bros.**

CONTRACTOR **Prince Bros.**


Hugoton Pool

1320 Ft. from N. Line

_____ Ft. from S. Line

_____ Ft. from E. Line

1320 Ft. from W. Line

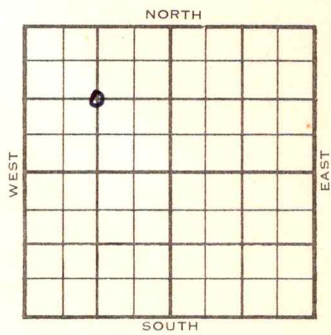

C NW/4
Northern Natural FO

1954	ELEVATION 2841'	REPORT
------	---------------------------	--------

9/8 Spud 8-27-54
8" @ 532'
Her. 2644', Kri. 2703', Win 2757'

9/29 Spud 8-27-54 Gas well TD 2735
8" @ 532' **Her. 2644 Kri. 2703**
Win. 2757 TD 2735 5" @ 2731
CO to TD 76/2636-48 84/2656-70
3000 A CO to 2678 dolo-frac.
Comp. 6,999,000 CFGPD

COMPLETED

County **Seward** State **Kansas**

Sec. **3** (Blk. Twp.) **32** (Sur. Rge.) **32W** Map No.

Operator **Prince Bros.**

Well No. **1** Farm **Wessler**

Elev. Location **C NW/4**



1320 Ft. From **N** Line **NW**

1320 Ft. From **W** Line Quarter

1st. Report **SEP 8 1954**

Completion

Remarks **Northern Natural FO**

Prince Bros. - Contr.

Spudding Date **8-27-54**

Drlg. Data **Hugoton Pool**

8" @ 532 Her. 2644 Kri1 2703

Win. 2757

FABEN GILSTRAP

County Seward State Kansas

Sec. 3 (Blk. 32 (Sur. 32W (Twp.) 32W Map No.

Operator Prince Bros.

Well No. 1 Farm Wessler

Elev. 2841 Location C NW/4



1320 Ft. From N Line NW

1320 Ft. From W Line Quarter

Ist. Report Sep 8 1954

Completion SEP 29 1954

Remarks Northern Natural FO

Prince Bros. - Contr.

Spudding Date 8-27-54

Drlg. Data Gas well TD 2735 Hugoton Pool

8" @ 532 Her. 2644 Kri. 2703

Win. 2757 TD 2735 5" @ 2731 CO to TD

76/ 2636-48 84/ 2656-70 3000 A

CO to 2678 dolo-frac

Comp. 6,999,000 cfpd

FABEN GILSTRAP