


Section 5 Township 32 Range 32W

Well No. #1 Jones "E"

Company Cities Service

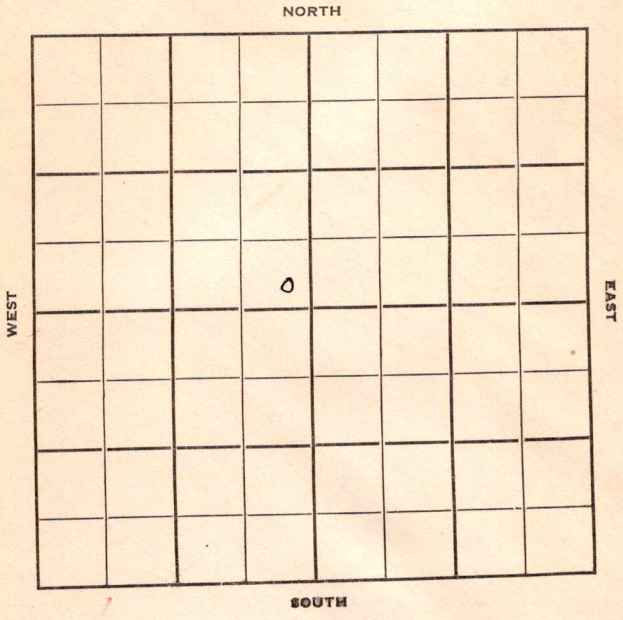

Sec. 5 Twp. 32 R. 32W

Well No. #1 Jones "E" Farm

Cities Service

Company

Contractor

Hugoton Pool

Ft. from N. Line

100'


Ft. from S. Line

100'

Ft. from E. Line

Ft. from W. Line

SE NW

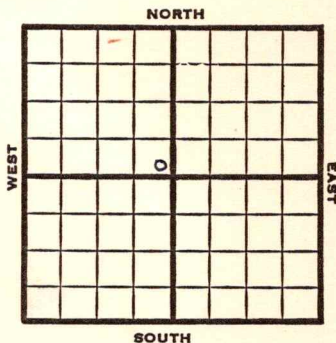

1951

Elev. 2849

REPORT

8/8

Spud 8-2-51

8" @ 519

Drlg. 2145'

10/3

Spud 8-2-51

Gas Well TD 2745

8" @ 519

5" @ 2744

TD 2745

Her. 2638

Kri. 2666'

110/2696-2718

60/2666-78 40/2650-58

20/2638-42

20,500 A Comp. 5,420,000 gas

COMPLETED

County **Seward** State **Kansas**

Sec. **5** (Blk. **32**) (Sur. **32W**) Map No.

Operator Cities Service

Well No. 1 Farm Jones "E"

[illegible]

FIRST REPORT

100 Ft. From S Line NW

100 Ft. From E Line Quarter

1st. Report **AUG 8 1951**

Completion

Remarks


Spudding Date 8-2-51

Drlg. Data Hugoton Pool

8" @ 519 drlg. 2145

J. E. TYRA

County Seward State Kansas
 Sec. 5 (Blk. Twp.) 32 (Sur. Rge.) 32W Map No. _____
 Operator Cities Service
 Well No. 1 Farm Jones "E"
 Elev. 2849 Location SE NW

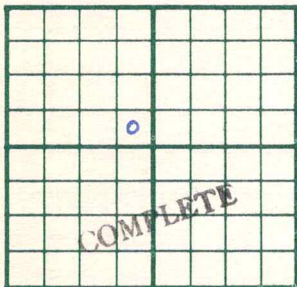

100 Ft. From S Line NW
100 Ft. From E Line Quarter

1st. Report

Completion OCT 3 1951

Remarks Hugoton Pool

Spudding Date 8-2-51

Drlg. Data Gas well TD 2745

8" @ 519 5" @ 2744 TD 2745

Her. 2638 Kri. 2666 110/ 2696-2718

60/ 2666-78 40/ 2650-58 20/ 2638-42

20500 A Comp. 5,420,000 gas

J. E. TYRA