


Section 6 Township 32 Range 32W

Well No. #1 Cotton

Company Cities Service

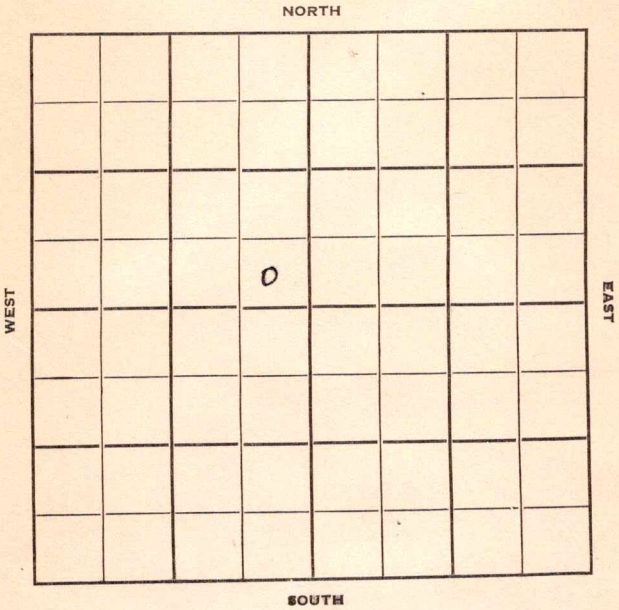

Sec. 6 Twp. 32 R. 32W

Well No. #1 Cotton Farm

Cities Service Company

Carbour & Barber Contractor


Hugoton Pool

100' Ft. from N. Line

_____ Ft. from S. Line

100' Ft. from E. Line

_____ Ft. from W. Line

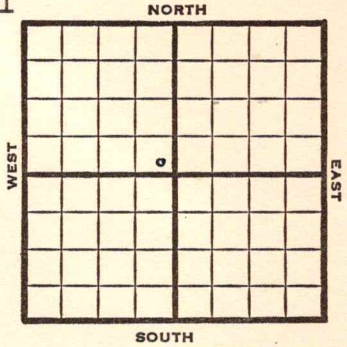

SE NW

1950

Elev 2859

REPORT

9/27

RUR

11/15

Spud 9-26-50

8" @ 520

5" @ 2799

Her 2634

Win 2705

TD 2800

80/2740-50

1000 A

water

Sq. off

140/2686-2714

64/2660-68

60/2636-46


17500 A

Comp 6,850,000 gas 417#

Completed



Krider 2659

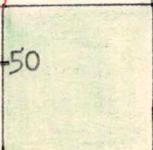

COMPLETED

County Seward State Kansas

Sec. 6 (Blk.) 32 (Sur.) 32W Map No.

Operator Cities Service

Well No. 1 Farm Cotton

Elev. 2859 Location SE NW

		0			

COMPLETE

100 Ft. From N Line NW

100 Ft. From E Line Quarter

Ist. Report

Completion NOV 1 5 1950

Remarks Hugoton Pool

Barbour - Contr.

Spudding Date 9-26-50

Drlg. Data Gas well TD 2800

8" @ 520 5" @ 2799 Her. 2634

Krider 2659 Win. 2705 TD 3800

80/ 2740-50 1000 A water sq. off

140/ 2686-2714 64/ 2660-68 60/ 2636-46

17500 A Comp. 6,850,000 gas 417#

J. E. TYRA