


Section 4 Township 32 Range 32W

Well No. 1 Collingwood

Company Northern Natural

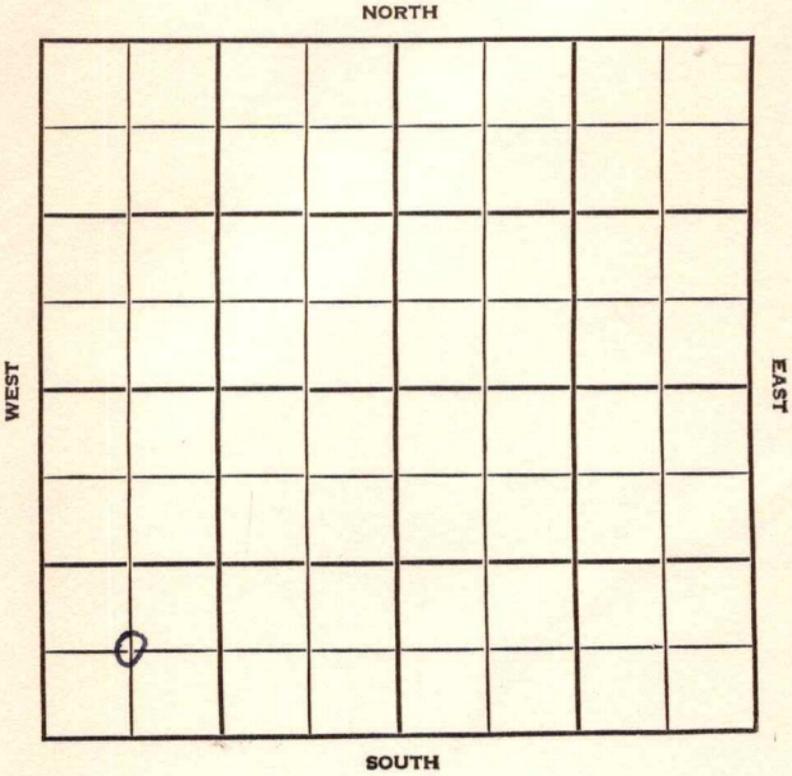



(Information Brought Forward)

1954

7/21

25000A

36/2654-60, 132/2676-98

Top. 2648, Br. lime 2704', 3500 A

Comp. 1, 470,000 cfgpd

**COMPLETED**



County Seward State Kansas

Sec. 4 (Blk. 32) (Sur. 3 2W) (Twp.) (Rge.) Map No.

Operator Northern Natural

Well No. 1 Farm Collingwood

Elev. 2848 Location C SWSW


660 Ft. From S Line SW

660 Ft. From W Line Quarter

1st. Report

Completion JUL 21 1954

Remarks

Spudding Date 4-26-54

Drlg. Data Gas well TD 5027

10" @ 519 Hol. 2589 Her. 2655

Kri. 2738 Win. 2785 Heeb. 4210

Lans. 4335 TD 5025 DD 5027 5" @ 5027

Marm. 4984 CO to 5020 48/ 5002-10

S/ 30 gw 500 A S/ sw SP 4995

36/ 4855-61 B/ 400gswph SP 4848

30/ 4826-31 250 A S/2200' sw

SP 4792 40/ 4774-80 500 M-A

1000 A 3000 A PB 4398 48/ 4336-44

500 M-A 3000 A S/ 15 bo 5 bawph

5 hr. S/ 120 bf 10% oil 90% sw

PB 4281 72/ 4253-65 500 M-A


72/ 4152-64 3500 A S/ sw 66/ 3782-93

PB 3631 60/ 3506-16 500 M-A

J. G. McGEHEE

Drlg. Data

CO to 4052 16/ 4038-42 500 M-A  
S/ sw SP 2775 4/ 2758-59 250 M-A  
CO to 2740 98/ 2706-22 1500 A  
25000 A 36/ 2654-60 132/ 2676-98  
Top. 2648 Br. 7 line 2704 3500 A  
Comp. 1,470,000 c f g p d

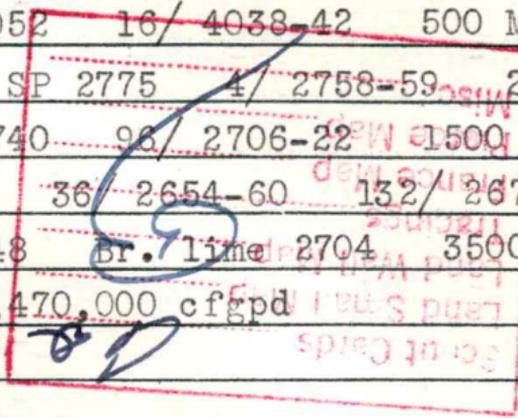

JUL 27 1954