


Section 15 Township 32 Range 32 W

Well No. " 1 Roy Lambert

Company Draper Motors Corp.

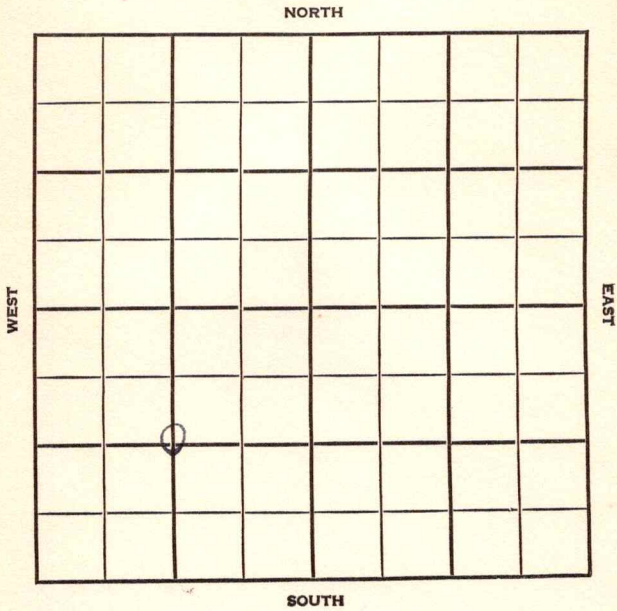

HOT FILE Seward KANSAS

SEC.	TWP.	R.
15	32	32 W

WELL NO. # 1 Roy Lambert FARM

COMPANY Draper Motors Corp.

CONTRACTOR


Hugoton Pool

_____ Ft. from N. Line

1320 _____ Ft. from S. Line

_____ Ft. from E. Line

1320 _____ Ft. from W. Line

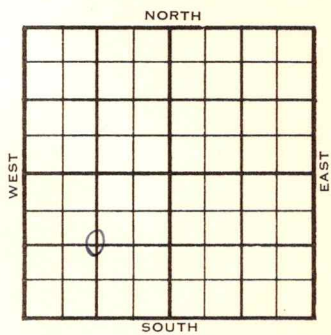

C SW/4

Norther Nat. FO (MCPC has S/2 Sec. 13)

	ELEVATION	REPORT
1954	2836'	
12/22	Spud 12-19-54	
	8" @ 612	WOC
12/23	Spud 12-19-54	8" @ 612 WOC
		(Ltr-Gilstrap)
12/30	Log Top: Herr 2685'	RTD 2690'
	D & A.	"
12/29	Spud 12-19-54	8" @ 612 Her. 2685
	TD 2690'	D & A
	ABANDONED	

County Seward State Kansas

Sec. 15 (Blk. Twp.) 32 (Sur. Rge.) 32W Map No.

Operator Draper Motors Corp.

Well No. 1 Farm Roy Lambert

Elev. _____ Location C SW/4

1320 Ft. From S Line SW

1320 Ft. From W Line Quarter

Ist. Report DEC 22 1954

Completion _____

Remarks Northern Nat. farmout

Spudding Date 12-19-54

Drlg. Data Hugoton Pool

8" @ 612 WOC

FABEN GILSTRAP

County Seward State Kansas

Sec. 15 (Blk. Twp.) 32 (Sur. Rge.) 32W Map No.

Operator Draper Motors Corp.

Well No. 1 Farm Roy Lambert

Elev. 2836 Location C SW/4

ABANDONED

1320 Ft. From S Line SW

1320 Ft. From W Line Quarter

1st. Report

Completion DEC 29 1954

Remarks Hugoton Pool

Spudding Date 12-19-54

Drlg. Data

8" @ 612 Her. 2685 TD 2690

D & A

FABEN GILSTRAP