

34-32-3300 PI

TYPE



AFFIDAVIT ~~State~~ *Geological Survey* COMPLETION FORM
WICHITA BRANCH

ACO-1 WELL HISTORY

Compt. _____

SIDE ONE

Two (2) copies of this form shall be filed with the Kansas Corporation Commission, 200 Colorado Derby Building, Wichita, Kansas 67202, within thirty (30) days after the completion of a well, regardless of how the well was completed.

F Attach separate letter of request if the information is to be held confidential. If confidential, only file one copy. Information on Side One will be of public record and Side Two will then be held confidential.

Applications must be made on dual completion, commingling, salt water disposal, injection and temporarily abandoned wells.

C ☒ XX Attach one copy only wireline logs (i.e. electrical log, sonic log, gamma ray neutron log, etc.). (Rules 82-2-105 & 82-2-125) KCC# (316) 263-3238. No Log

LICENSE # 5670 EXPIRATION DATE 6-30-83

OPERATOR IREX Corp. API NO. 15-175-20,679

ADDRESS 1670 Broadway, Suite 3301 COUNTY Seward

Denver, CO 80202 FIELD Wildcat

** CONTACT PERSON Linda Drennen/Well Records Supervisor PROD. FORMATION Dry Hole
PHONE _____

PURCHASER N/A LEASE LEMERT #1

ADDRESS _____ WELL NO. 1

WELL LOCATION SW/SW

DRILLING Contractor Murfin Drilling Co. 660 Ft. from South Line and

ADDRESS 617 Union Center Bldg. 660 Ft. from West Line of

Wichita, KS 67202 the (Qtr.) SEC 34 TWP 32S RGE 33 (W).

PLUGGING Leo Swords

CONTRACTOR ADDRESS Box 288

Russell, KS 67665

TOTAL DEPTH 6400 PBTD _____

SPUD DATE 3-01-83 DATE COMPLETED N/A 3-16-83

ELEV: GR 2738 DF 2749 KB 2750

DRILLED WITH (CABLE) (ROTARY) (AIR) TOOLS.

DOCKET NO. OF DISPOSAL OR REPRESSURING WELL BEING USED TO DISPOSE OF WATER FROM THIS LEASE EPC#19333


Amount of surface pipe set and cemented 1519 DV Tool Used? No

THIS AFFIDAVIT APPLIES TO: (Circle ONE) - Oil, Gas, Shut-in Gas, Dry, Disposal, Injection, Temporarily Abandoned, OWWO. Other _____

ALL REQUIREMENTS OF THE STATUTES, RULES AND REGULATIONS PROMULGATED TO REGULATE THE OIL AND GAS INDUSTRY HAVE BEEN FULLY COMPLIED WITH. Yes

WELL PLAT

(Office Use Only)

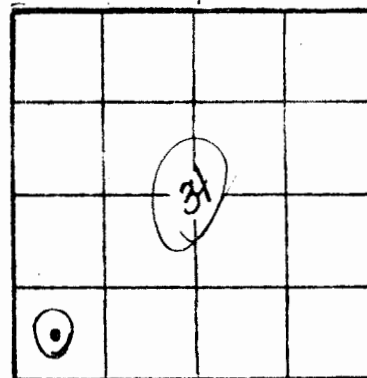

KCC
KGS ☒
SWD/REP
PLG. _____

A F F I D A V I T

I, William H. Bayliff, Operations Manager, being of lawful age, hereby certifies that:

I am the Affiant, and I am familiar with the contents of the foregoing Affidavit. Statements and allegations contained therein are true and correct.

SIDE TWO

ACO-1 WELL HISTORY (E)

OPERATOR IREX Corp.

LEASE LEMERT #1 SW/SW SEC. 34 TWP. 32S RGE. 33 (W)

FILL IN WELL INFORMATION AS REQUIRED:

WELL NO.

Show all important zones of porosity and contents thereof; cored intervals, and all drill-stem tests, including depth interval tested, cushion used, time tool open, flowing and shut-in pressures, and recoveries.

SHOW GEOLOGICAL MARKERS, LOGS RUN, OR OTHER DESCRIPTIVE INFORMATION.

FORMATION DESCRIPTION, CONTENTS, ETC.	TOP	BOTTOM	NAME	DEPTH
Check if no Drill Stem Tests Run.				
DST #1, 5475-5570, U. Morrow. Open 15-30-60-120 min. IHP 2730 FHP 2634 IFP 464 FFP 480 ISIP 641 FSIP 641 Rec. 150' mud, 120' DM, & 540' SW. Good blow throughout.				
DST #2, 5814-6048, misrun.				
DST #3, 5880-6000, Chester. Open 15-30-60-120 min. IHP 3294 FHP 3013 IFP 102 FFP 153-178 ISIP 230 FSIP 230 Rec. 2045 DM.				
Heebner (-1380)	4130			
Toronto (-1391)	4146			
Lansing (-1516)	4266			
Marmaton (-2166)	4916			
Morrow (-2734)	5484			
U. Morrow Sd. (-2762)	5512			
Chester (-2952)	5702			
St. Genevieve (-3294)	6044			
St. Louis (-3470)	6220			
Loggers T.D.	6407			
Cyberlook	4000	6400		
CNL w GR	4000	6400		
DIL-SFL w/ GR	1500	6407		
If additional space is needed use Page 2, Side 2				

Report of all strings set — surface, intermediate, production, etc. CASING RECORD (New) or (Used)

Purpose of string	Size hole drilled	Size casing set (in O.D.)	Weight lbs/ft.	Setting depth	Type cement	Sacks	Type and percent additives
Surface	12 1/4	8 5/8	24#	1519	Class "H" Halco Lite	200 600	3% CC 3% CC

LINER RECORD

PERFORATION RECORD


Top, ft.	Bottom, ft.	Sacks cement	Shots per ft.	Size & type	Depth interval
TUBING RECORD					
Size	Setting depth	Pecker set at			

WELL LOG

COMPANY Irex Corporation
FARM Lemert NO. 1
RIG. NO. 22
TOTAL DEPTH 6400
COMM. 3-1-83
CONTRACTOR Murfin Drilling Co.

SEC. 34 T. 32S R. 33W
LOC. C SW SW

COUNTY Seward
KANSAS

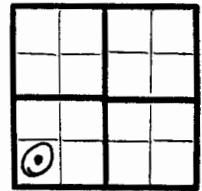

State Geological Survey
WICHITA BRANCH

CASING
20 10 600 sx Howco Lite, 3% CC
15 8 -5/8" @ 1519 w/800 sx 200 sx Class H, 3% CC ELEVATION
12 6
13 5

PRODUCTION

FIGURES INDICATE BOTTOM OF FORMATIONS

Surface Dirt	195
Red Bed	840
Lime & Shale	1519
Red Bed & Shale	1970
Lime & Shale	5570
Lime, Shale & Sand	5657
Lime & Shale RTD	6400

RECEIVED
STATE CORPORATION COMMISSION

MAY 16 1983

CONSERVATION DIVISION
Wichita, Kansas