


Section 29 Township 32 Range 33-W

Well No. #1 Naden

Company Cabot Carbon

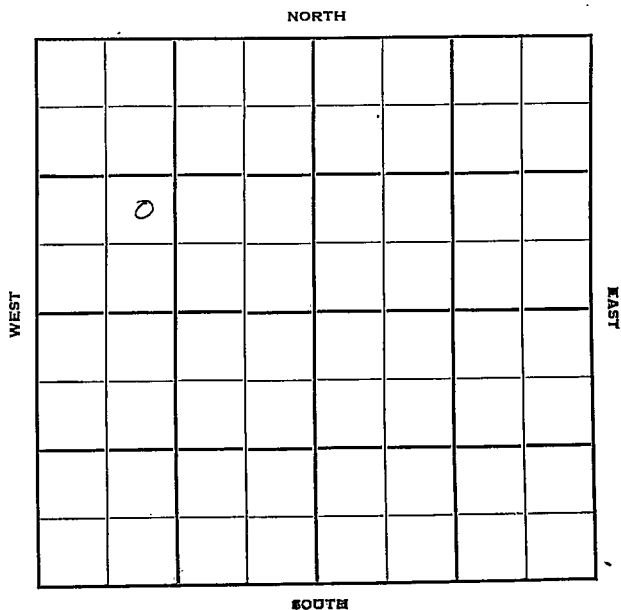

Seward

KANSAS

Sec. 29 Twp. 32 R. 33W

Well No. #1 Naden Farm

Cabot Carbon Company

Contractor

Hugoton Pool


1450' Ft. from N. Line

_____ Ft. from S. Line

_____ Ft. from E. Line

1200' Ft. from W. Line

NE SW NW

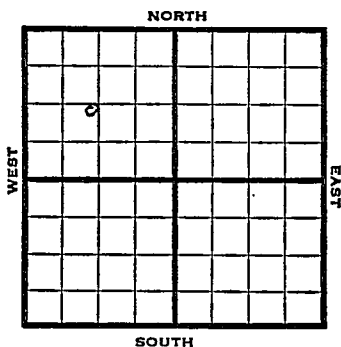

1950

Elev 2770' REPORT

10/25

Location

12/6

10" @ 407

7" @ 2504

TD 2665

Comp 1,608,000 gas 426#

Completed

COMPLETED

County Seward State KansasSec. 29 (Blk.) 32 (Sur.) 33W Map No.Operator Cabot CarbonWell No. 1 Farm NadenElev. 2770 Location NE SW NW

1450 Ft. From N Line NW1200 Ft. From W Line Quarter1st. Report OCT 18 1950


Completion

Remarks

Spudding Date

Drlg. Data Hugoton PoolLocation

J. E. TYRA

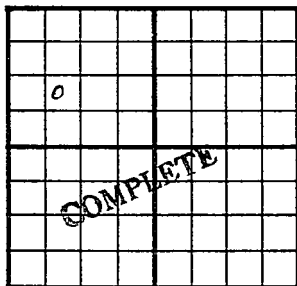County Seward State KansasSec. 29 (Blk.) 32 (Sur.) 33W Map No.Operator Cabot CarbonWell No. 1 Farm NadenElev. 2770 Location NE SW NW1450 Ft. From N Line NW1200 Ft. From W Line Quarter

1st. Report

Completion DEC 6 1950Remarks Hugoton Pool

Spudding Date

Drilg. Data Gas well TD 266510" C 407 7" C 2504 TD 2665Comp. 1,608,000 gas 426#

J. E. TYRA