


Seward

KANSAS

FORM 51 25M 3-49 PETROL

Section 30 Township 32 Range 33^WWell No. #1 LuffCompany Cabot Carbon

NORTH

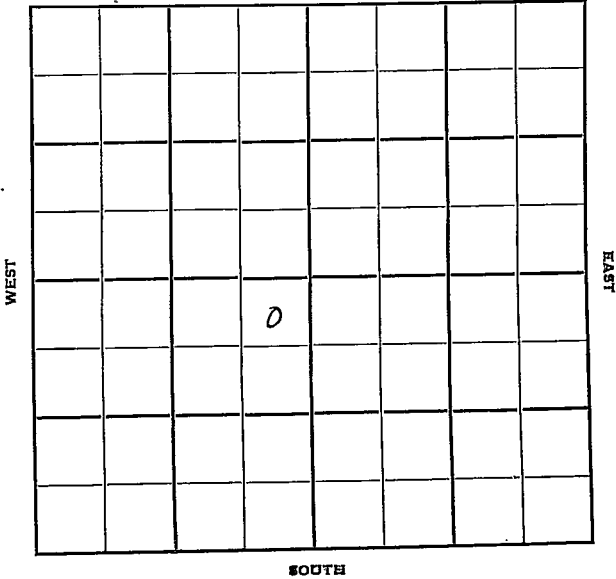

KANSAS

Seward

Sec. 30 Twp. 32 R. 33-W ✓

Well No. #1 Luff Farm

Cabot Carbon Company

Hugoton Contractor

330 Ft. from N. Line


Ft. from S. Line

330 Ft. from E. Line

Ft. from W. Line

NE NE SW

Elev 2826'

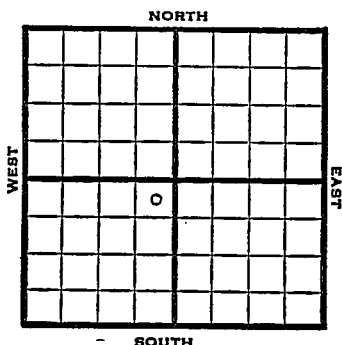

10/18 Spud 10-7-50 REPORT

10" @ 480

7" @ 2528

RTD 2530

12/13 10" @ 480

7" @ 2574

TD 2619


Her 2525 Krider 2562

18000 total acid

Comp 14,424,000 gas

Completed

COMPI FTED

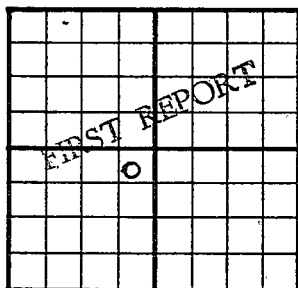County Seward State KansasSec. 30 (Blk.) 32 (Sur.) 33W Map No.Operator Cabot CarbonWell No. 1 Farm LuffElev. 2826 Location NE NE SW330 Ft. From N Line SW330 Ft. From E Line Quarter1st. Report OCT 18 1950

Completion

Remarks

Spudding Date 10-3-50Drlg. Data Hugoton Pool10" @ 480 7" @ 2528 RTD 2530

J. E. TYRA

J. E. TYRA