


Section 31 Township 32 Range 33W

Well No. #1 V. Corrigan

Company Cabot Carbon

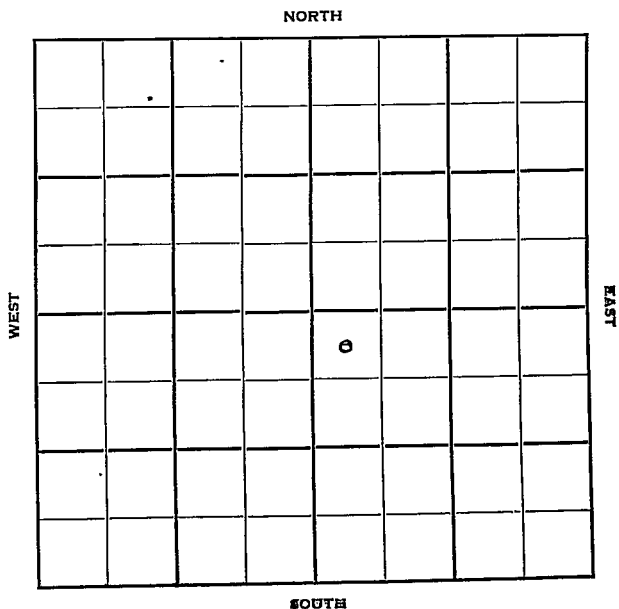

KANAS

Seward

Sec. 31 Twp. 32 R. 33-W ✓

Well No. #1 V. Corrigan Farm

Cabot Carbon Company

Hugoton Contractor


330 Ft. from N. Line

         Ft. from S. Line

         Ft. from E. Line

330 Ft. from W. Line

NW NW SE

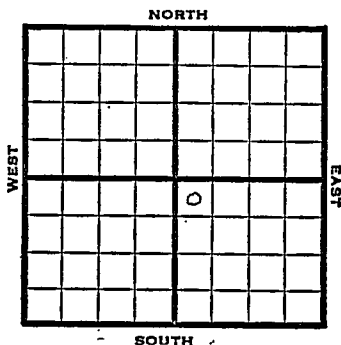

1950 Elev 2866' REPORT

10/18 Spud 10-10-50  
10" @ 521  
12/6 10" @ 521  
Her 2570  
TD 2665  
Comp 22,736,000 gas  
Completed  
**COMPLETED**

County Seward State KansasSec. 31 (Blk. Twp.) 32 (Sur. Rge.) 33W Map No.Operator Cabot CarbonWell No. 1 Farm V. CorriganElev. Location NW NW SE

|  |  |  |  |  |  |  |  |
|--|--|--|--|--|--|--|--|
|  |  |  |  |  |  |  |  |
|  |  |  |  |  |  |  |  |
330 Ft. From N Line SE330 Ft. From W Line Quarter1st. Report OCT 18 1950

Completion

Remarks

Spudding Date 10-10-50Drilg. Data Hugoton Pool10" @ 521

J. E. TYRA

Operator Cabot Carbon

Well No. 1 Farm V. Corrigan

|       |      |          |          |
|-------|------|----------|----------|
| Elev. | 2866 | Location | NW NW SE |
|-------|------|----------|----------|

330 Ft. From N Line SE

330 Ft. From W Line Quarter

### 1st. Report

Completion DEC 6 1950

|         |              |
|---------|--------------|
| Remarks | Hugoton Pool |
|---------|--------------|

Spudding Date

Drilg. Data      Gas well      TD 2665

10" © 521 Her. 2570 TD 2665

Comp. 22,736,000 gas

J. E. TYRA