


Section 32 Township 32 Range 33-W

Well No. #1 Fisher

Company Cabot Carbon

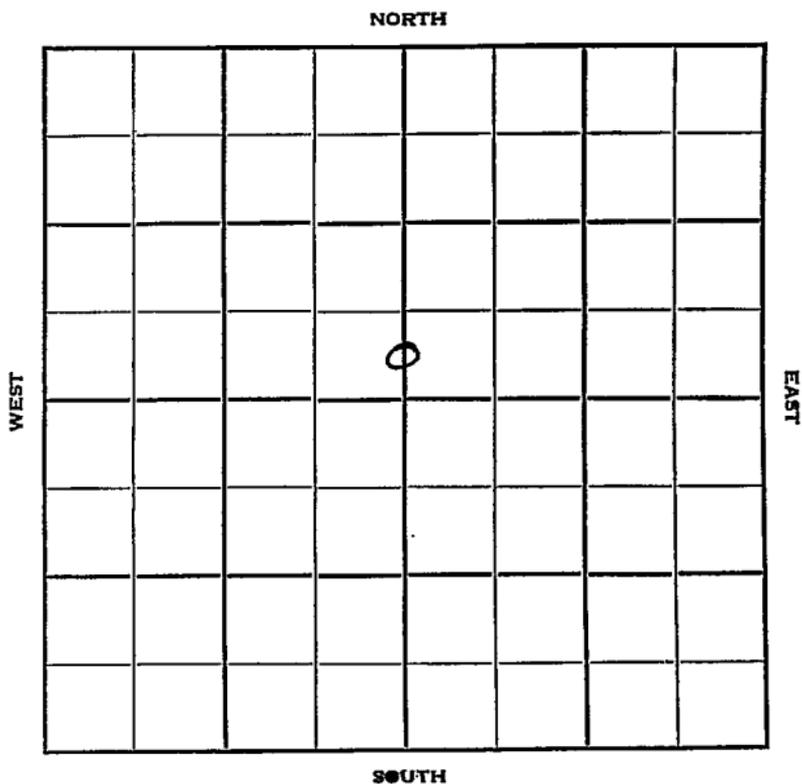

Seward



Sec. 32 Twp. 32 R. KANS/33W

Well No. #1 Fisher Farm

Cabot Carbon Company

Hugoton Pool Contractor


2310' Ft. from N. Line

\_\_\_\_\_ Ft. from S. Line

\_\_\_\_\_ Ft. from E. Line

2640' Ft. from W. Line

C S L N $\frac{1}{2}$  Sec.

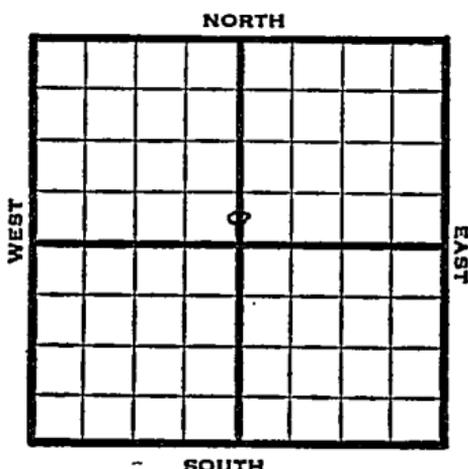

1950	REPORT
	Elev. 2843
11/15	Spud 11-3-50 10" @ 460' Drlg. 2050'
1951 2/7	Spud 11-3-50 Gas well TD 2653 10" @ 460 Her. 2565 Win. 2650 7" @ 2574 20000 A Comp. 888,000 gas  <b>COMPLETED</b>



County Seward State Kansas

Sec. 32 (Blk. 32 (Sur. Rge.) 33W Map No.

Operator Cabot Carbon

Well No. 1 Farm Fisher

Elev. 2843 Location C S L N $\frac{1}{2}$  Sec.


2310 Ft. From N Line Sec.

2640 Ft. From W Line Quarter

lst. Report

Completion FEB 7 1951

Remarks Hugoton Pool

Spudding Date 11-3-50

Drlg. Data Gas well TD 2653

10" @ 460 Her. 2565 Win. 2650

7" @ 2574 20000 A. Comp. 888,000 gas