

Seward

KANSAS


DX 78-1

Section 3 Township 32 Range 33W

Well No. 1 Hille & Gas Unit

Company Stanolind

NORTH

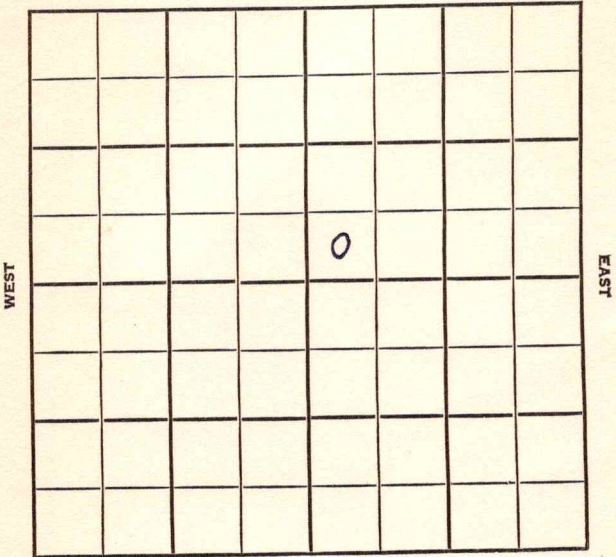

SOUTH

Seward

KANSAS

SEC.	TWP.	R.
3	32	33W

WELL NO.

1 Hille Gas Unit

FARM

COMPANY

Stanolind

CONTRACTOR

Hugoton Pool

Ft. from N. Line

150


Ft. from S. Line

Ft. from E. Line

150

Ft. from W. Line

SW SW NE

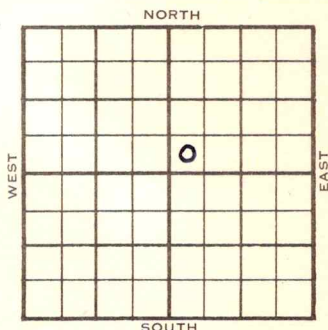

1954

ELEVATION 2690'

REPORT

7/21

Location

9/15

Spud 8-2-54

Gas Well

TD 2736'

8-5/8" @ 630'

Her. 2679', Kri. 2714',

TD 2736'

5" @ 2714'

CO to 2736'

2600 A 607,000 cfg. 3 gwph

PB 2707

24/ 2679-83 30/ 2685-90 18/ 2698-

2701 2000 A 1,200,000 cfg.

15 gwph CO to 2734

1,164,000 cfg. 7 gwph 7000 A

1,426,000 cfg. 30 gwph

TD 2736'

SP 2724 2,016,000 cfg. 20 gwph.

Comp open flow 4,509,000 cfgpd.

COMPLETED

FABEN GILSTRAP