

Seward

FORM 51


KANSAS

Section 4 Township 32 Range 33W

Well No. #1 Jarrett Gas Unit

Company Stanolind

NORTH

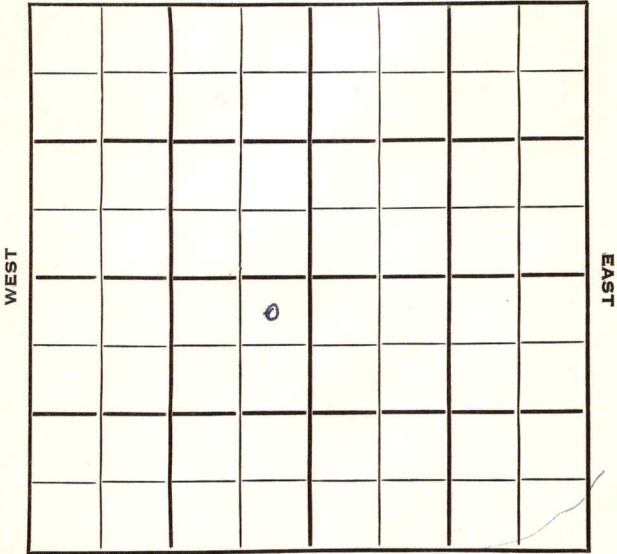

SOUTH

SEC.	4	TWP.	32	R.	33W ✓
------	---	------	----	----	-------


WELL NO. #1 Jarrett Gas Unit FARM

COMPANY Stanolind

CONTRACTOR

Hugoton Pool

150 Ft. from N. Line  
 Ft. from S. Line  
 150 Ft. from E. Line  
 Ft. from W. Line

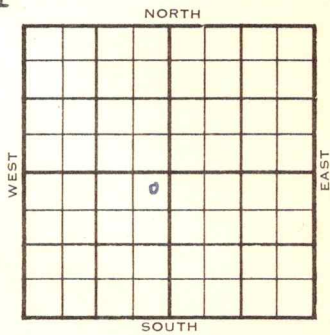

NE NE SW

1954	ELEVATION 2860'	REPORT
------	--------------------	--------

2/17  
 3/24  
 4/28

Location  
 8" @ 606'  
 Drlg 2673'  
 Spud 3-18-54 Gas well TD 2697  
 8" @ 606 Her. 2622 Kri. 2665  
 TD 2697 5" @ 2665 CO to 2697  
 2500 A 24/2622-26 12/2632-34  
 30/2636-41 18/2645-48 2000 A  
 7000 A A-frac.  
 Comp. 1,063,000 gasl.

**COMPLETED**



