


Section 17 Township 32 Range 33W

Well No. #1 Johnson

Company Cabot Carbon

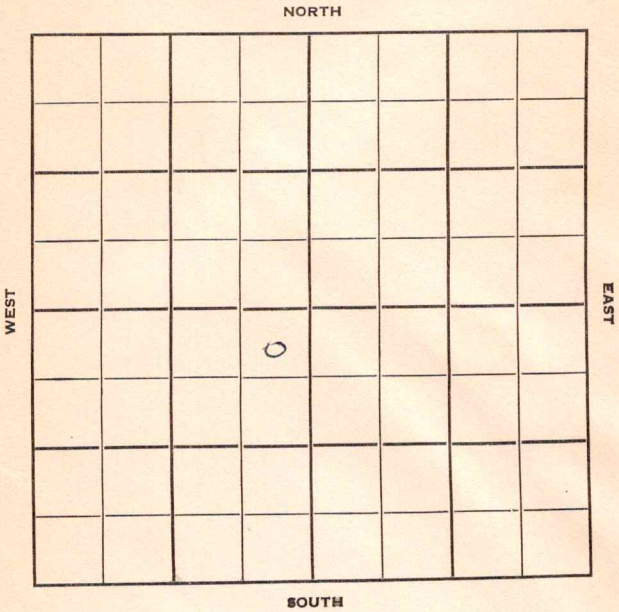

Seward

KANSAS

Sec. 17 Twp. 32 R. 33W ✓

Well No. #1 Johnson Farm

Cabot Carbon

Company

Hills & Hills - Contr.

Contractor

Hugoton Pool


330' Ft. from N. Line

_____ Ft. from S. Line

330' Ft. from E. Line

_____ Ft. from W. Line

NE NE SW

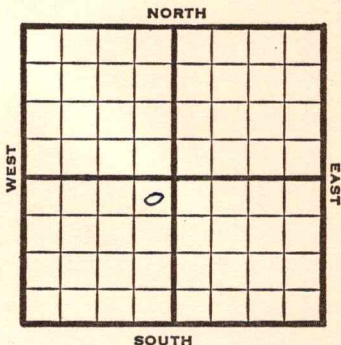

1950

Elev 2767

REPORT

10/4

Spud 9-23-50

10" @ 489'

TD 2508'

7" @ 2508'

12/6

10" @ 489

TD 2508

7" @ 2508

DD 2633

19500 A

Comp 12,833,000 gas

TD 2633

Completed

COMPLETED

County **Seward** State **Kansas**
 Sec. **17** (Blk.) **32** (Sur.) **33W** Map No.
 Operator **Cabot Carbon**
 Well No. **1** Farm **Johnson**
 Elev. Location **NE NE SW**

FIRST REPORT

0

330 Ft. From **N** Line **SW**
330 Ft. From **E** Line Quarter

1st. Report **OCT 4 1950**

Completion

Remarks

Hills & Hills - Contr.


Spudding Date **9-23-50**

Drlg. Data

Hugoton Pool

10" @ 489 TD 2508 7" @ 2508

J. E. TYRA

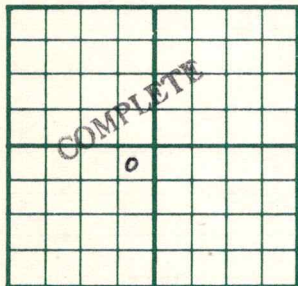County Seward State KansasSec. 17 (Blk.
Twp.) 32 (Sur.
Rge.) 33W Map No.Operator Cabot CarbonWell No. 1 Farm JohnsonElev. 2767 Location NE NE SW330Ft. From N Line SW330Ft. From E Line Quarter1st. ReportCompletion DEC 6 1950Remarks Hugoton PoolHill & Hill - Contr.Spudding Date 9-23-50Drlg. Data Gas well TD 263310" @ 489 TD 2508 7" @ 2508 DD 263319500 A Comp. 12,833,000 gas

J. E. TYRA