


Section 20 Township 32 Range 33W

Well No. #1 Mercer

Company Spencer Chemical
Hugoton Pool

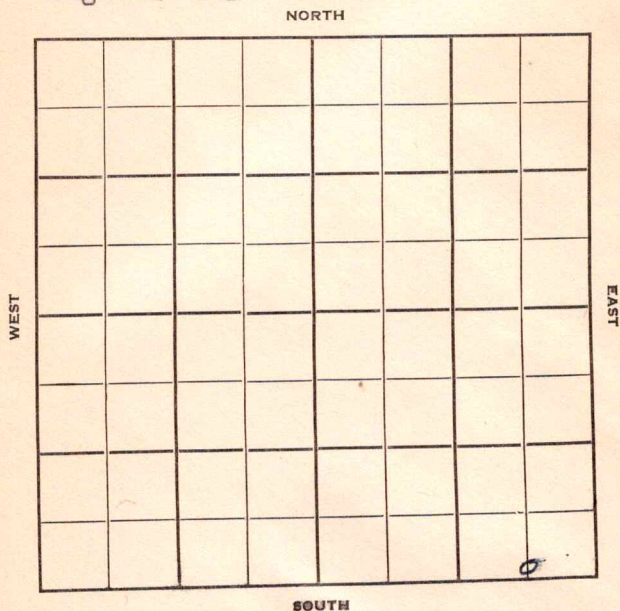

Map No. _____ Sec. 20 Twp. 32 R. 33W


Well No. 1 Mercer

Spencer Chemical Company

Contractor

C S L SE

**FIRST REPORT
SECTION PLAT**

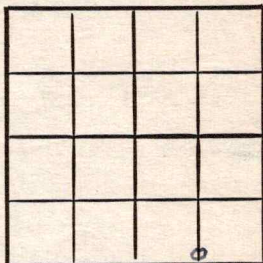

_____ Ft. from N. Line

150 Ft. from S. Line

1320 Ft. from E. Line

_____ Ft. from W. Line

Seward County

Location _____

Rig up _____

Drilling and Remarks:

R U R

RECORD

Cased _____ in., _____ ft.

Sand _____

Gas _____

Oil _____

Total Depth _____

PRODUCTION

1st 24 hrs. Nat. _____

1st 24 hrs. after shot _____

Gas _____ Cu. Ft.


Dry Hole _____

Abandoned _____

Date

DEC 14 1949 19

S. J. LEWIS Scout

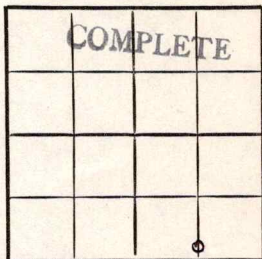Map No. _____ Sec. 20 Twp. 32 R. 33WWell No. 1 Mercer_____Spencer Chemical_____
Company_____
Contractor
C S L SEEl. 2700
SECTION PLAT_____Ft. from N. Line_____150 Ft. from S. Line_____1320 Ft. from E. Line_____Ft. from W. Line_____Seward County_____

Location _____

Rig up _____

Drilling and Remarks:

10" @ 4927" @ 244411,400,000
cu ft gas

RECORD

Cased _____ in., _____ ft.

Sand _____

Gas _____

Oil _____

Total Depth 2548

PRODUCTION

1st 24 hrs. Nat. _____

1st 24 hrs. after shot _____

Gas _____ Cu. Ft.

Dry Hole _____

Abandoned _____

Date

JAN 25 1950J. E. TYRA19Scout