

CONFIDENTIAL

SIDE ONE

Ind
P1

STATE CORPORATION COMMISSION OF KANSAS
OIL & GAS CONSERVATION DIVISION

WELL COMPLETION OR RECOMPLETION FORM
ACO-1 WELL HISTORY

DESCRIPTION OF WELL AND LEASE

Operator: License # 5447
Name Cities Service Oil & Gas Corp.
Address 3545 N.W. 58th Street
City/State/Zip Okla., City, Okla., 73112

Purchaser: Panhandle Eastern Pipeline Co.
Kansas City, Missouri 64141

Operator Contact Person Raymond Hui
Phone (405) 949-4400

Contractor: License # 7860
Name Johnson Drilling Co.

Wellsite Geologist David Smith
Phone (405) 949-4400

Designate Type of Completion

☒ New Well ☐ Re-Entry ☐ Workover
☐ Oil ☐ SWD ☐ Temp Abd
☒ Gas ☐ Inj ☐ Delayed Comp
☐ Dry ☐ Other (Core, Water Supply etc.)

If OWWO: old well info as follows:

Operator
Well Name
Comp. Date Old Total Depth

WELL HISTORY

Drilling Method:

☒ Mud Rotary ☐ Air Rotary ☐ Cable

5-15-85 5-25-85 6-27-85
Spud Date Date Reached TD Completion Date
6450' 6403'
Total Depth PBTD

Amount of Surface Pipe Set and Cemented at 1697 feet
Multiple Stage Cementing Coilar Used? ☐ Yes ☒ No
If yes, show depth set feet
If alternate 2 completion, cement circulated
from feet depth to w/ SX cmt

API NO. 15-175-20854

County Seward

SE. SE. NW. Sec. 28. Twp. 32S. Rge. 34. ☐ East ☒ West
(2405' FWL, 2310' FNL)

2970 Ft North from Southeast Corner of Section
2875 Ft West from Southeast Corner of Section
(Note: Locate well in section plat below)


Lease Name Hitch "R" Well # 1

Field Name N. Shuck

Producing Formation Chester

Elevation: Ground 2912' DE: 2923'

Section Plat

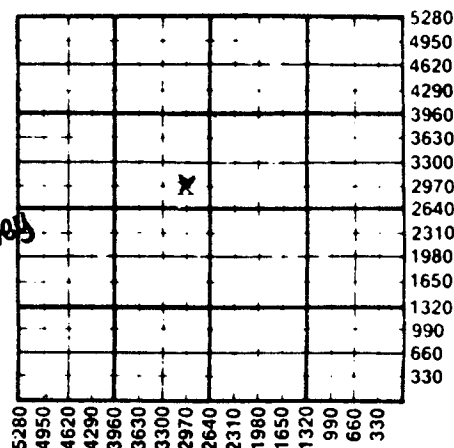

WATER SUPPLY INFORMATION

Disposition of Produced Water: ☐ Disposal
Docket # ☐ Repressuring

Questions on this portion of the ACO-1 call:

Water Resources Board (913) 296-3717

Source of Water:
Division of Water Resources Permit # T85-456

☒ Groundwater 3040 Ft North from Southeast Corner
(Well) 2875 Ft West from Southeast Corner of
Sec 28 Twp 32S Rge 34 ☐ East ☒ West

☐ Surface Water Ft North from Southeast Corner
(Stream, pond etc) Ft West from Southeast Corner
Sec Twp Rge ☐ East ☐ West

☐ Other (explain) (purchased from city, R.W.D. #)

INSTRUCTIONS: This form shall be completed in duplicate and filed with the Kansas Corporation Commission, 200 Colorado Derby Building, Wichita, Kansas 67202, within 90 days after completion or recompletion of any well. Rule 82-3-130 and 82-3-107 apply.
Information on slide two of this form will be held confidential for a period of 12 months if requested in writing and submitted with the form. See rule 82-3-107 for confidentiality in excess of 12 months.
One copy of all wireline logs and drillers time log shall be attached with this form. Submit CP-4 form with all plugged wells. Submit CP-111 form with all temporarily abandoned wells.